

WELL PLUGGING RECORD

Give All Information Completely
Make Required Affidavit
Mail or Deliver Report to:
Conservation Division
State Corporation Commission
211 No. Broadway
Wichita, Kansas

Hodgeman County, Sec. 3 Twp. 22S Rge. 22W (X) (W)

Location as "NE/CNW/SW" or footage from lines. C SE SW

Lease Owner Socony Mobil Oil Company, Inc.

Lease Name Everett Salmans Well No. 2 Core Hole

Office Address 300 No. Broadway - Wichita, Kansas - 67202

Character of Well (completed as Oil, Gas or Dry Hole) Core Test Hole

Date well completed 4-13-64 19

Application for plugging filed 4-23-64 19

Application for plugging approved 4-24-64 19


Plugging commenced 4-28-64 19

Plugging completed 4-28-64 19

Reason for abandonment of well or producing formation Plug Core Test Hole

If a producing well is abandoned, date of last production 19

Was permission obtained from the Conservation Division or its agents before plugging was commenced?

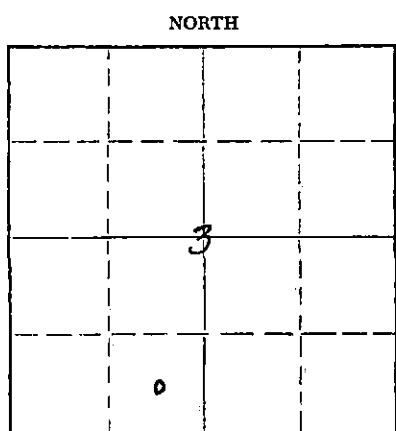

Locate well correctly on above Section Plat

Name of Conservation Agent who supervised plugging of this well Hugh Scott

Producing formation Depth to top Bottom Total Depth of Well Feet

Show depth and thickness of all water, oil and gas formations.

OIL, GAS OR WATER RECORDS

CASING RECORD

FORMATION	CONTENT	FROM	TO	SIZE	PUT IN	PULLED OUT

Describe in detail the manner in which the well was plugged, indicating where the mud fluid was placed and the method or methods used in introducing it into the hole. If cement or other plugs were used, state the character of same and depth placed, from feet to feet for each plug set.

Hauled 40 bbls mud mixed with 40 bbls salt water and added 4 sacks zeogel. Circulated 8 jts. 2" tubing to 250'. Circulated 20 minutes. Cemented with 85 sacks of pozmix cement to surface.

RECEIVED
STATE CORPORATION COMMISSION

JUN 8 1964

CONSERVATION DIVISION
Wichita, Kansas

(If additional description is necessary, use BACK of this sheet)

Name of Plugging Contractor Socony Mobil Oil Company, Inc. (Pulling Unit)

Address 300 No. Broadway - Wichita, Kansas - 67202

STATE OF Kansas, COUNTY OF Sedgwick, ss.
T. V. Herriage (employee of owner) or (owner) of the above-described

well, being first duly sworn on oath, says: That I have knowledge of the facts, statements, and matters herein contained and the log of the above-described well as filed and that the same are true and correct. So help me God.

(Signature) J. V. Herriage Dist. Acctg Group Supvr.

300 No. Broadway - Wichita, Kansas - 67202 (Address)

SUBSCRIBED AND SWORN to before me this 4th day of June, 19 64

My commission expires 4-4-66

Jack Bearden Notary Public.