


STATE OF KANSAS
STATE CORPORATION COMMISSION
Give All Information Completely
Make Required Affidavit
Mail or Deliver Report to:
Conservation Division
State Corporation Commission
211 No. Broadway
Wichita, Kansas

WELL PLUGGING RECORD

NORTH

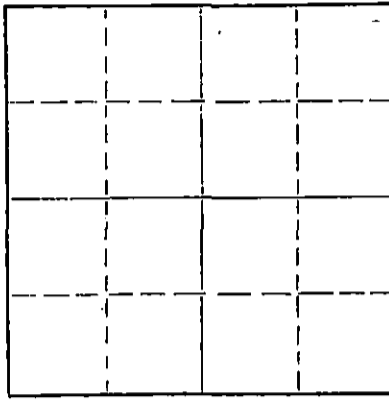

Locate well correctly on above
Section Plat

Hodgeman County. Sec 2 Twp. 22S Rge. (E) 22 (W)
Location as "NE/CNW/SW" or footage from lines C SW SW
Lease Owner Pickrell Drilling Company
Lease Name Johnson No. 1 Well No. _____
Office Address 705 Fourth National Bank Bldg, Wichita 2, Kansas
Character of Well (completed as Oil, Gas or Dry Hole) Dry Hole
Date well completed February 18, 1964
Application for plugging filed February 18, 1964
Application for plugging approved February 18, 1964
Plugging commenced February 18, 1964
Plugging completed February 18, 1964
Reason for abandonment of well or producing formation Dry Hole

If a producing well is abandoned, date of last production _____ 19____
Was permission obtained from the Conservation Division or its agents before plugging was commenced? Yes

Name of Conservation Agent who supervised plugging of this well Frank Broadfoot
Producing formation _____ Depth to top _____ Bottom _____ Total Depth of Well 4560 Feet
Show depth and thickness of all water, oil and gas formations.

OIL, GAS OR WATER RECORDS

CASING RECORD

FORMATION	CONTENT	FROM	TO	SIZE	PUT IN	PULLED OUT
				8 5/8	271'	None

Describe in detail the manner in which the well was plugged, indicating where the mud fluid was placed and the method or methods used in introducing it into the hole. If cement or other plugs were used, state the character of same and depth placed, from _____ feet to _____ feet for each plug set.

Heavy mud to 270 feet. Set plug. Cemented
with 25 sacks cement. Heavy mud to 40 feet.
Set plug. Cemented with 10 sacks cement to
bottom of cellar. Plugged rat hole with 2
sacks cement.

3-16-64
RECEIVED
STATE CORPORATION COMMISSION

MAR 16 1964

CONSERVATION DIVISION
Wichita, Kansas

(If additional description is necessary, use BACK of this sheet)

Name of Plugging Contractor PICKRELL DRILLING COMPANY
Address 705 Fourth National Bank Bldg, Wichita 2, Kansas

STATE OF KANSAS, COUNTY OF SEDGWICK, ss.
C. W. SEBITS (owner or operator) of the above-described well, being first duly sworn on oath, says: That I have knowledge of the facts, statements, and matters herein contained and the log of the above-described well as filed and that the same are true and correct. So help me God.
(Signature) C. W. Sebits
705 4th Natl Bank Bldg, Wichita 2, Kansas
(Address)

SUBSCRIBED AND SWORN to before me this 24th day of February, 19 64

My commission expires: June 21, 1966
Maxine Blackman
Maxine Blackman, Notary Public.

ROTARY DRILLING LOG

COMPANY: PICKRELL DRILLING COMPANY
705 4th National Bank Building
Wichita 2, Kansas

LOCATION: Johnson No. 1, C SW SW Section 2-22S-22W
Hodgeman County, Kansas

Rotary Drilling Commenced 2--5-64Rotary Drilling Completed 2-18-64

CONTRACTOR: **PICKRELL DRILLING COMPANY**
Wichita, Kansas

CASING RECORD: (13 jts) 8 5/8" surface casing set at 271', cemented with 180 sacks cement. Circulated. Completed 6:00 P.M. February 5, 1964. No oil string run, D & A.

LOG

(Figures indicate bottom of formation — measurements from top of rotary bushing.)

60	Sandy Clay	<u>C. F. S.</u>
160	Sandy, Shale & Shells	4374
585	Shale & Shells	4425
710	Red Beds & Shale	4435
725	Blaine	4440
810	Shale & Shells	4445
1005	Sand	4450
1355	Red Beds, Shells & Shale	4455
1395	Anhydrite	4560
1730	Red Bed, Shale & Shells	
1890	Shale	<u>Slope Tests</u>
2025	Shale, Lime	2500
2150	Lime, Shells & Shale	3000
2757	Lime	3500
2875	Lime, Shells & Shale	4000
3638	Lime & Shale	
3720	Sandy Lime & Shale	<u>S. L. M.</u>
3864	Lime & Shale	3907
3988	Lime	4156
4060	Lime & Shale	4394
4150	Lime	
4390	Lime & Shale	
4418	Lime	
4440	Mississippian Dolomite	
4440	Mississippian Chert	
4547	Mississippian	
4560	Gilmore City	
4560	RTD	

RECEIVED
STATE CORPORATION COMMISSION

MAR 16 1964

CONSERVATION DIVISION
Wichita, Kansas

The undersigned, C. W. Sebitts, Attorney-in-Fact for PICKRELL DRILLING COMPANY, hereby certifies in behalf of said Company, that the above is a true and correct log of the formation encountered in drilling the above well as reflected by the Daily Drilling Reports.

PICKRELL DRILLING COMPANY

By C. W. Sebitts Attorney-in-Fact

STATE OF KANSAS }
COUNTY OF SEDGWICK } ss.:

On this 24th day of February, 1964, before me the undersigned, a Notary Public, in and for the County and State aforesaid, personally appeared C. W. Sebitts, to me known to be the identical person who subscribed the name of PICKRELL DRILLING COMPANY to the foregoing instrument as its Attorney-in-Fact and acknowledged to me that he executed the same as his free and voluntary act and deed, and as the free and voluntary act and deed of such company, for the uses and purposes therein set forth.

Given under my hand and seal of office the day and year last above written.

My commission expires: June 21, 1966

Maxine Blackman
Maxine Blackman Notary Public