


STATE OF KANSAS
STATE CORPORATION COMMISSION
CONSERVATION DIVISION
P. O. BOX 17037
WICHITA, KANSAS 67217

FORM CP-4

WELL PLUGGING RECORD

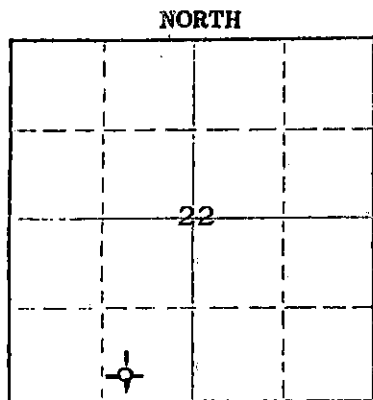

Locate well correctly on above Section Plot

Kingman County, Sec. 22 Twp. 30S Rge. 9W xxx (W)
Location as "NE/CNW/SE/SW" or footage from lines: SW SE SW
Lease Owner: D. R. Lauck Oil Company, Inc.
Lease Name: Swingle Well No. 1
Office Address: 301 S. Broadway, Wichita, Kansas 67202
Character of Well (completed as Oil, Gas or Dry Hole): Dry Hole
Date well completed: March 31, 1976
Application for plugging filed: March 31, 1976
Application for plugging approved: March 31, 1976
Plugging commenced: March 31, 1976
Plugging completed: March 31, 1976
Reason for abandonment of well or producing formation: Dry Hole

If a producing well is abandoned, date of last production: 19____
Was permission obtained from the Conservation Division or its agents before plugging was commenced? Yes

Name of Conservation Agent who supervised plugging of this well: G. R. Biberstein
Producing formation: _____ Depth to top: _____ Bottom: _____ Total Depth of Well: 4375 Feet
Show depth and thickness of all water, oil and gas formations.

OIL, GAS OR WATER RECORDS

CASING RECORD

FORMATION	CONTENT	FROM	TO	SIZE	PUT IN	PULLED OUT
		0'	263'	8-5/8"	263'	None

Describe in detail the manner in which the well was plugged, indicating where the mud fluid was placed and the method or methods used in introducing it into the hole. If cement or other plugs were used, state the character of same and depth placed, from _____ feet to _____ feet for each plug set.

Spotted with 35 sacks cement at 250',
15 sacks at 40', 2 sacks in rat hole.

(If additional description is necessary, use BACK of this sheet)

Name of Plugging Contractor: Halliburton Cementing Co.
Address: Great Bend, Kansas

STATE OF KANSAS COUNTY OF SEDGWICK ss.
John D. Knightley (employee of owner) or (owner or operator) of the above-described

well, being first duly sworn on oath, says: That I have knowledge of the facts, statements, and matters herein contained and the log of the above-described well as filed and that the same are true and correct. So help me God.

(Signature) [Signature]
301 S. Broadway, Wichita, Kansas
(Address)

SUBSCRIBED AND SWORN TO before me this 5th day of April, 1976

My commission expires March 12, 1979

[Signature] Notary Public.

RECEIVED
STATE CORPORATION COMMISSION

APR 09 1976

CONSERVATION DIVISION
Wichita, Kansas

4-9-76

D. R. Lauck Oil Company, Inc. -

Swingle #1
SW SE SW Sec. 22-30S-9W
Kingman County, Kansas

Contractor: D. R. Lauck Oil Company, Inc.
301 S. Broadway
Wichita, Kansas 67202

Commenced: March 19, 1976
Completed: March 31, 1976

Drillers Log

Clay & Sand	60
Shale	290
Shale & Shells	1320
Shale & Lime	2185
Lime & Shale	3300
Lime	4330
Chert	4375 RTD

RECEIVED
STATE COMMISSION

APR 09 1976

CONSERVATION DIVISION
Wichita, Kansas