


STATE OF KANSAS
STATE CORPORATION COMMISSION

Form CP-4

WELL PLUGGING RECORD

Give All Information Completely
Make Required Affidavit
Mail or Deliver Report to:
Conservation Division
State Corporation Commission
212 No. Market
Wichita, Kansas

NORTH

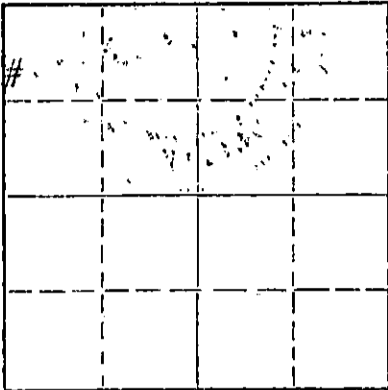

Locate well correctly on above
Section Plat

Kingman County, Sec. 22 Twp. 30 Rge. 9 (E) W (W)

Location as "NE/CNW/SW" or footage from lines SW NW NW

Lease Owner Pickrell Drilling Co.

Lease Name Swingle "B" Well No. 2

Office Address 705 Fourth Nat'l Bank Bldg. Wichita, Ks.

Character of Well (completed as Oil, Gas or Dry Hole) Oil

Date well completed June 30, 1960

Application for plugging filed Feb. 28, 1969

Application for plugging approved Mar. 3, 1969

Plugging commenced Mar. 14, 1969

Plugging completed Mar. 18, 1969

Reason for abandonment of well or producing formation Depleted

If a producing well is abandoned, date of last production Jan. 31, 1969

Was permission obtained from the Conservation Division or its agents before plugging was commenced? Yes

Name of Conservation Agent who supervised plugging of this well Ralph Warren

Producing formation Mississippian Depth to top 4299 Bottom 4396 Total Depth of Well 4396 Feet

Show depth and thickness of all water, oil and gas formations.

OIL, GAS OR WATER RECORDS

CASING RECORD

FORMATION	CONTENT	FROM	TO	SIZE	PUT IN	PULLED OUT
				8 5/8	240'	None
				5 1/2	4394'	3533'

Describe in detail the manner in which the well was plugged, indicating where the mud fluid was placed and the method or methods used in introducing it into the hole. If cement or other plugs were used, state the character of same and depth placed, from _____ feet to _____ feet for each plug set.

Plugged back with sand from 4366' to 4300'. Mixed and dumped 5 sx. of cement from 4300' to 4260'. Pulled casing. Mudded hole to 220'. Set 10' rock bridge from 220' to 210'. Mixed and dumped 25 sx. of cement from 210' to 135'. Mudded hole from 135' to 40'. Set 10' rock bridge from 40' to 30'. Mixed and dumped 10 sx. of cement from 30' to base of the cellar.

RECEIVED
STATE CORPORATION COMMISSION
APR 7 1969
CONSERVATION DIVISION
Wichita, Kansas

(If additional description is necessary, use BACK of this sheet)

Name of Plugging Contractor Russ Casing Pulling Inc.

Address Box 1082 Great Bend, Ks.

STATE OF Kansas, COUNTY OF Sedgwick, ss.

C. W. Sebitts (employee of owner) or (owner or operator) of the above-described

well, being first duly sworn on oath, says: That I have knowledge of the facts, statements, and matters herein contained and the log of the above-described well as filed and that the same are true and correct. So help me God.


(Signature) C. W. Sebitts, Partner & Attorney-in-Fact
705 4th Nat'l Bank Bldg., Wichita, Ks. 67202
(Address)

Subscribed and sworn to before me this 7th day of April, 1969

My commission expires May 10, 1970

L. M. Whiting

Notary Public.

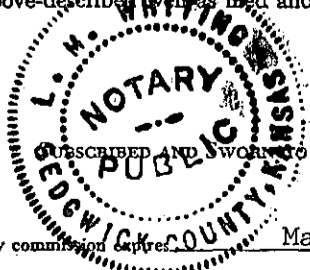

ROTARY DRILLING LOG

COMPANY: Pickrell Drilling Company
705 Fourth National Bank Building
Wichita, Kansas

Rotary Drilling Commenced 6-6-60

Rotary Drilling Completed 6-17-60

LOCATION: Swingle "B" #2
SW-NW-NW Section 22-30S-9W
Kingman, County, Kansas

CONTRACTOR: **PICKRELL DRILLING COMPANY**
Wichita, Kansas

CASING RECORD: Ran 6 jts. 8-5/8" 22.7# Armco Spiralweld Casing. Cemented with 185 sks.
Set @ 240'.

Ran 143 jts. 5 1/2" 14# J-55 Smlc. casing, set @ 4394.59'. Cemented with 90 sks.

LOG

(Figures indicate bottom of formation — measurements from top of rotary bushing.)

50	Sand and Clay		
80	Sand		
240	Red Rock		4308'
600	Shale and Clay		4320'
1210	Shale and Shells		4330'
1500	Shale, broken Lime, Salt and Gyp		4335'
3195	Lime and Shale		4345'
3326	Lime, Shale and Sand		4355'
3390	Lime and Shale		4395
3580	Sand and Shale		
3652	Sandy Lime, Shale and Lime		
4044	Lime		
4224	Lime and Shale		500 00
4286	Lime		1000 00
4297	Lime and Shale		1500 00
4395	Mississippi	k T. D.	

Circulated for Samples

Slope Tests

S. M. L.

2000' OK
3000' OK
4000' OK

RECEIVED
STATE CORPORATION COMMISSION
FEB 28 1969
CONSERVATION DIVISION
Wichita, Kansas

The undersigned, C. W. Sebitts, Attorney-in-Fact for PICKRELL DRILLING COMPANY, hereby certifies in behalf of said Company, that the above is a true and correct log of the formation encountered in drilling the above well as reflected by the Daily Drilling Reports.

PICKRELL DRILLING COMPANY

By [Signature]
C. W. Sebitts, Partner

STATE OF KANSAS }
COUNTY OF SEDGWICK } ss.:

23rd day of June, 1960, before me the undersigned, a Notary Public, in and for C. W. Sebitts

State aforesaid, personally appeared _____, to me known to be the _____ person who subscribed the name of PICKRELL DRILLING COMPANY to the foregoing instrument as its Attorney-in-Fact and acknowledged to me that he executed the same as his free and voluntary act and deed, and as the free and voluntary act and deed of such company, for the uses and purposes therein set forth.

Given under my hand and seal of office the day and year last above written.

My commission expires: September 24, 1962

[Signature]
Notary Public

Maxine Johnson

