


STATE OF KANSAS
STATE CORPORATION COMMISSION

Give All Information Completely
Make Required Affidavit
Mail or Deliver Report to:
Conservation Division
State Corporation Commission
211 No. Broadway
Wichita, Kansas

WELL PLUGGING RECORD

NORTH

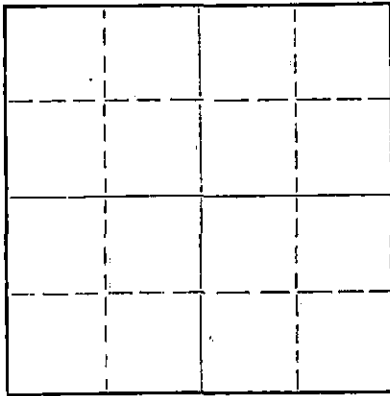

Locate well correctly on above
Section Plat

Kingman County. Sec. 22 Twp. 30 Rge. (E) 9 (W)
Location as "NE/CNW/SW" or footage from lines NW SE NW
Lease Owner Pickrell Drilling Company
Lease Name Swingle "B" Well No. 3
Office Address 705 4th National Bank Building, Wichita 2, Kansas
Character of Well (completed as Oil, Gas or Dry Hole) Dry Hole
Date well completed January 23, 1964
Application for plugging filed January 23, 1964
Application for plugging approved January 23, 1964
Plugging commenced January 23, 1964
Plugging completed January 23, 1964
Reason for abandonment of well or producing formation Dry Hole

If a producing well is abandoned, date of last production 19
Was permission obtained from the Conservation Division or its agents before plugging was commenced? Yes

Name of Conservation Agent who supervised plugging of this well Fred Hampel
Producing formation _____ Depth to top _____ Bottom _____ Total Depth of Well 4385 Feet
Show depth and thickness of all water, oil and gas formations.

OIL, GAS OR WATER RECORDS

CASING RECORD

FORMATION	CONTENT	FROM	TO	SIZE	PUT IN	PULLED OUT
				8 5/8	260'	None

Describe in detail the manner in which the well was plugged, indicating where the mud fluid was placed and the method or methods used in introducing it into the hole. If cement or other plugs were used, state the character of same and depth placed, from _____ feet to _____ feet for each plug set.

Heavy mud to 260'. Set plug. Cemented with
25 sacks cement. Heavy mud to 40'. Set plug.
Cemented with 10 sacks cement to bottom of
cellar. Plugged rat hole with 2 sacks cement.

RECEIVED
STATE CORPORATION COMMISSION

FEB 25 1964

2-25-64
CONSERVATION DIVISION
Wichita, Kansas

(If additional description is necessary, use BACK of this sheet)

Name of Plugging Contractor Pickrell Drilling Company
Address 705 4th National Bank Building, Wichita 2, Kansas

STATE OF KANSAS, COUNTY OF SEDGWICK, ss.

C. W. SEBTS (owner or operator) of the above-described well, being first duly sworn on oath, says: That I have knowledge of the facts, statements, and matters herein contained and the log of the above-described well as filed and that the same are true and correct. So help me God.

(Signature) C. W. Sebts
705 4th Nat'l Bank Bldg, Wichita 2, Kansas
(Address)

SUBSCRIBED AND SWORN to before me this 24th day of January 1964

Maxine Blackman
Notary Public.

My commission expires June 21, 1966

ROTARY DRILLING LOG

COMPANY: PICKRELL DRILLING COMPANY
705 4th National Bank Building
Wichita, Kansas

Rotary Drilling Commenced 1-11-64

Rotary Drilling Completed 1-23-64

LOCATION: Swingle "B" No. 3, NW SE NW Section 22-30S-9W,
Kingman County, Kansas

CONTRACTOR: **PICKRELL DRILLING COMPANY**
Wichita, Kansas

CASING RECORD: (12 jts) 8 5/8" surface casing set at 235', cemented with 175 sacks cement. Circulated. Completed 4:35 A.M. January 12, 1964. No oil string run, D & A.

LOG

(Figures indicate bottom of formation — measurements from top of rotary bushing.)

80	Sand	<u>C. F. S.</u>
234	Sand - Red Rock	4325
380	Red Rock	4335
1115	Shale & Shells	4342
1534	Shale & Lime	4352
1830	Lime	4357
3575	Lime & Shale	4385
4083	Lime	
4325	Lime & Shale	<u>Slope Tests</u>
4385	Mississippi - TD	2500
		3000
		3500
		4000
		<u>S. L. M.</u>
		3783
		4083
		4357

RECEIVED
STATE CORPORATION COMMISSION

FEB 25 1964

CONSERVATION DIVISION
Wichita, Kansas

The undersigned, C. W. SEBITS, Attorney-in-Fact for PICKRELL DRILLING COMPANY, hereby certifies in behalf of said Company, that the above is a true and correct log of the formation encountered in drilling the above well as reflected by the Daily Drilling Reports.

PICKRELL DRILLING COMPANY

By C. W. Sebits Attorney-in-Fact

STATE OF KANSAS }
COUNTY OF SEDGWICK } ss.:

On this 24th day of January, 1964, before me the undersigned, a Notary Public, in and for the County and State aforesaid, personally appeared C. W. SEBITS, to me known to be the identical person who subscribed the name of PICKRELL DRILLING COMPANY to the foregoing instrument as its Attorney-in-Fact, and acknowledged to me that he executed the same as his free and voluntary act and deed, and as the free and voluntary act and deed of such company, for the uses and purposes therein set forth.

Given under my hand and seal of office the day and year last above written.

Maxine Blackman
Maxine Blackman Notary Public

My commission expires: June 21, 1966