

STATE OF KANSAS
STATE CORPORATION COMMISSION
CONSERVATION DIVISION
200 Colorado Derby Building
Wichita, Kansas 67202

FORM CP-1
Rev. 03/92

WELL PLUGGING APPLICATION FORM
(PLEASE TYPE FORM and File ONE Copy)

API # 15-095-21,667-~~0000~~ (Identifier number of this well). This must be listed for wells drilled since 1967; if no API# was issued, indicate spud or completion date.

WELL OPERATOR Pickrell Drilling Co., Inc. KCC LICENSE # 5123
(owner/company name) (operator's)

ADDRESS 110 N. Market, Suite 205 CITY Wichita

STATE Kansas ZIP CODE 67202 CONTACT PHONE # (316) 262-8427

LEASE Lauterbach "B" WELL# 1 SEC. 21 T. 30S R. 9 (East/West)

- - SW - SW SPOT LOCATION/0000 COUNTY Kingman

802 FEET (in exact footage) FROM (S)N (circle one) LINE OF SECTION (NOT Lease Line)

4428 FEET (in exact footage) FROM (E)W (circle one) LINE OF SECTION (NOT Lease Line)

Check One: OIL WELL GAS WELL D&A SWD/ENHR WELL DOCKET#

CONDUCTOR CASING SIZE SET AT CEMENTED WITH SACKS

SURFACE CASING SIZE 8 5/8 SET AT 214 CEMENTED WITH 145 SACKS

PRODUCTION CASING SIZE 4 1/2 SET AT 4399 CEMENTED WITH 135 SACKS

LIST (ALL) PERFORATIONS and BRIDGEPLUG SETS: Perfs 4306-4308

ELEVATION 1637 KB T.D. 4400 PBD 4353 Heebner ANNEXE DEPTH 3413
(G.L./K.B.) (Stone Corral Formation)

CONDITION OF WELL: GOOD POOR CASING LEAK JUNK IN HOLE

PROPOSED METHOD OF PLUGGING Plug back w/sand to 4250. Use dump bailer to spot 5 Sx. of cement on sand. Cut and recover casing. Plug top hole per K.C.C. instructions. Call K.C.C. (316) 263-8809 for instructions re plugging top hole.
(If additional space is needed attach separate page)

IS WELL LOG ATTACHED TO THIS APPLICATION AS REQUIRED? Yes IS ACO-1 FILED? No

If not explain why? Will be filed after P&A.

PLUGGING OF THIS WELL WILL BE DONE IN ACCORDANCE WITH K.S.A. 55-101 et. seq. AND THE RULES AND REGULATIONS OF THE STATE CORPORATION COMMISSION.

LIST NAME OF COMPANY REPRESENTATIVE AUTHORIZED TO BE IN CHARGE OF PLUGGING OPERATIONS:

Don Aumiller PHONE# (316) 532-3511 10-12-92

ADDRESS P.O. Box 1303 City/State Kingman, Kansas 67068

PLUGGING CONTRACTOR Clark Corp. KCC LICENSE # 5105
(company name) (contractor's)

ADDRESS P.O. Box 187, Medicine Lodge, KS. 67104 PHONE # (316) 886-5665

PROPOSED DATE AND HOUR OF PLUGGING (If Known?) October 20 1992

PAYMENT OF THE PLUGGING FEE (K.A.R. 82-3-118) WILL BE GUARANTEED BY OPERATOR OR AGENT


DATE: 10-8-92 AUTHORIZED OPERATOR/AGENT: *Jack Gundry*
(signature)

2)

RECEIVED
STATE CORPORATION COMMISSION
6-13
OCT 12 1992
CONSERVATION DIVISION
Wichita Kansas

New Completion Workover

Oil Company Pickrell Drilling Well No. 1 Field Spivey Grobs Lease Houterbach "B"
 Company Man _____ Date Drilled 9/92 County Kingman State Kansas

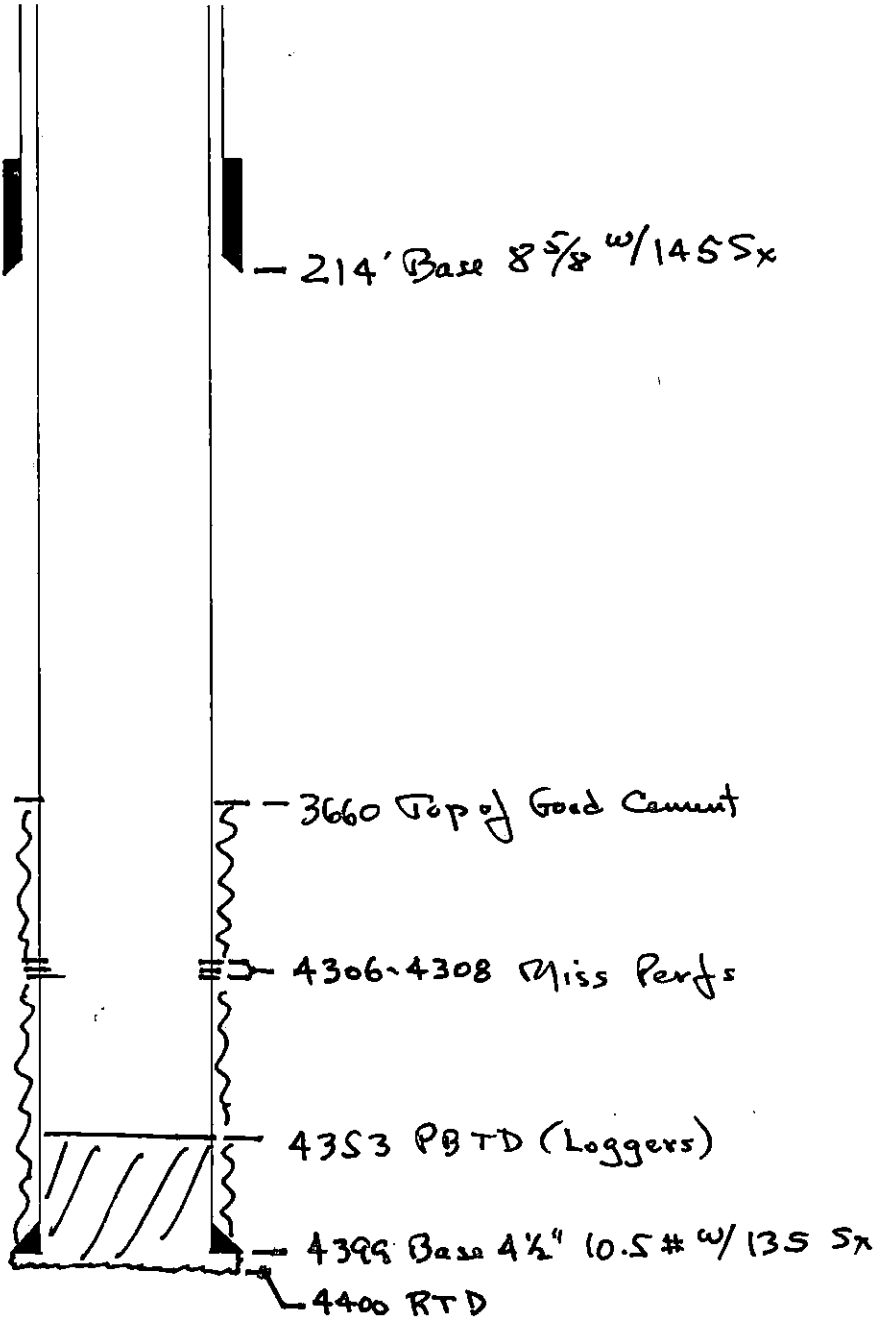

REMARKS: _____

RECEIVED
 STATE CORPORATION COMMISSION
 OCT 1 2 1992
 CONSERVATION DIVISION
 Wichita, Kansas



DUAL INDUCTION LATEROLOG

COMPANY PICKRELL DRILLING C WELL 1 LAUTERBACH B FIELD SPIVEY GRABS BASIL COUNTY KINGMAN STATE KS	COMPANY PICKRELL DRILLING COMPANY, INC.		
	WELL 1 LAUTERBACH B		
	FIELD SPIVEY GRABS BASIL		
	COUNTY KINGMAN	STATE KS	
API NO 15-155-21,216	OTHER SERVICES		
LOCATION 802 FSL 852 FWL	CDL/DSN		
SECT 21	THP 30S	RGE 9W	
PERMANENT DATUM G.L.	ELEV. 1632	ELEV.: K.B. 1637	
LOG MEASURED FROM K.B. 5	FT. ABOVE PERM DATUM	D.F. N.A.	
DRILLING MEASURED FROM K.B.		G.L. 1632	
DATE	9/9/92		
RUN NO.	ONE		
DEPTH-DRILLER	4400		
DEPTH-LOGGER	4399		
BTM. LOG INTER	4397		
TOP LOG INTER	217		
CASING DRILLER	8 5/8 @ 214	e	e
CASING-LOGGER	217		
BIT SIZE	7 7/8		
TYPE FLUID IN HOLE	CHEMICAL		
DENS. : VISC.	9.1 : 45	:	:
PH : FLUID LOSS	10.0 : 12.8	:	:
SOURCE OF SAMPLE	FLOWLINE		
RM @ MEAS. TEMP.	0.77 @ 66	e	e
RMF @ MEAS. TEMP.	0.59 @ 65	e	e
RMC @ MEAS. TEMP.	0.98 @ 65	e	e
SOURCE RMF:RMC	MEAS.:MEAS.	:	:
RM @ BHT	0.44 @ 122	e	e
TIME SINCE CIRC.	2 HOURS		
TIME ON BOTTOM	1:30 AM		
MAX. REC TEMP.	122 @ T.D.	e	e
EQUIP.: LOCATION	51299:GT.B.	:	:
RECORDED BY	BARB		
WITNESSED BY	MR. KLAVER		

RECEIVED

KANSAS CORPORATION COMMISSION

OCT 12 1992

CONSERVATION DIVISION
WICHITA, KS

Joan Finney
Governor

Jim Robinson
Chairman

F. S. Jack Alexander
Commissioner

Rachel C. Lipman
Commissioner

Judith McConnell
Executive Director

Brian Moline
General Counsel



Kansas Corporation Commission

NOTICE OF RECEIPT OF WELL PLUGGING APPLICATION

October 14, 1992

Pickrell Drilling Co Inc
110 N Market 205
Wichita KS 67202

Lauterbach B 1
API 15-095-21,667
SW SW
Sec. 21-30-09W
Kingman County

Dear Operator:

This letter is to notify you that the Conservation Division is in receipt of your plugging proposal, form CP-1, for the above-captioned well.

Your CP-1 has been reviewed by the Conservation Division central office for completeness and to verify license numbers. The plugging proposal will now be forwarded to the district office listed below for review of your proposed method of plugging. Please contact the district office for approval of your proposed plugging method at least at five (5) days before plugging the well, pursuant to K.A.R. 82-3-113 (b). Failure to do so is punishable by an administrative penalty of up to \$1000. If a workover pit will be used during the plugging of the well it must be permitted. A CDP-1 form must be filed and approved prior to the use of the pit.

It has recently come to my attention that the form CP-1 has been filed by operators other than the owner or operator of the well and without the consent of the owner or operator. The Conservation Division's review of form CP-1, either in the central or district office, does not include an inquiry into well ownership or the filing operator's legal right to plug the well.

This notice in no way constitutes authorization to plug the above-captioned well by persons not having legal rights of ownership or interest in the well. This notice is void after ninety (90) days from the above date.

Sincerely,

A handwritten signature in dark ink, appearing to read "David P. Williams".

David P. Williams
Production Supervisor

Conservation Division
William R. Bryson
Director
200 Colorado Derby Bldg.
202 W. 1st Street
Wichita, Kansas 67202-1286
Telephone (316) 263-3238

District: #2 202 W First Suite 304
Wichita KS 67202
(316) 263-8809