


STATE OF KANSAS
STATE CORPORATION COMMISSION

Form CP-4

Give All Information Completely
Make Required Affidavit
Mail or Deliver Report to:
Conservation Division
State Corporation Commission

WELL PLUGGING RECORD

P. O. Box 17027
Wichita, Kansas 67217

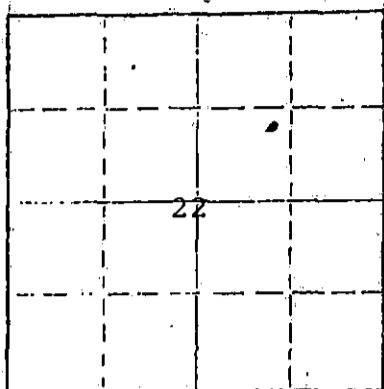

Locate well correctly on above
Section Plot

Hodgeman County, Sec 22 Twp 22S Rge. (E) 25 (W)
Location as "NE/GNW/SE/SW" or footage from lines 990 FS & 990 FWL of NE/4
Lease Owner Kewanee Oil Company
Lease Name Red Well No. 2 W.I.
Office Address Box 2093, Wichita, Kansas
Character of Well (completed as Oil, Gas or Dry Hole) oil - later W.I.
Date well completed 4-16-19 59
Application for plugging filed 5-28-19 74
Application for plugging approved 5-29-19 74
Plugging commenced 6-3-19 74
Plugging completed 6-12-19 74
Reason for abandonment of well or producing formation of no further use to waterflood.

If a producing well is abandoned, date of last production --- 19 ---
Was permission obtained from the Conservation Division or its agents before plugging was commenced? yes

Name of Conservation Agent who supervised plugging of this well Edgar J. Eves
Producing formation Mississippi Depth to top 4600 Bottom 4670 Total Depth of Well 4670 Feet
Show depth and thickness of all water, oil and gas formations.

OIL, GAS OR WATER RECORDS

CASING RECORD

FORMATION	CONTENT	FROM	TO	SIZE	PUT IN	PULLED OUT
Mississippi	oil	4600		8-5/8"	559	none
				5-1/2"	4690	3031

Describe in detail the manner in which the well was plugged, indicating where the mud fluid was placed and the method or methods used in introducing it into the hole. If cement or other plugs were used, state the character of same and depth placed, from _____ feet to _____ feet for each plug set.

Plugged back with sand to 4600'.
Dumped 5 sacks cement with bailer.
Pumped 5 sacks gel, 35 sacks cement
and 5 sacks of gel. Released plug
and plugged with 30 sacks cement,
5 sacks gel and 10 sacks cement.

RECEIVED
STATE CORPORATION COMMISSION
AUG 23 1974
CONSERVATION DIVISION
Wichita, Kansas

(If additional description is necessary, use BACK of this sheet)
Name of Plugging Contractor Southwest Casing Pulling Company
Address Great Bend, Kansas

STATE OF Kansas COUNTY OF Sedgwick ss.

B. J. Patton (employee of owner) or (owner) of the above-described

well, being first duly sworn on oath, says: That I have knowledge of the facts, statements, and matters herein contained and the log of the above-described well as filed and that the same are true and correct. So help me God.

(Signature) [Signature]

Box 2093, Wichita, Kansas 67201

(Address)

22nd day of August, 19 74

[Signature]
Billie Oden Notary Public.

My commission expires 8-10-75

