


WELL PLUGGING RECORD

Give All Information Completely
Make Required Affidavit
Mail or Deliver Report to:
Conservation Division
State Corporation Commission

P. O. Box 17027
Wichita, Kansas 67217
North

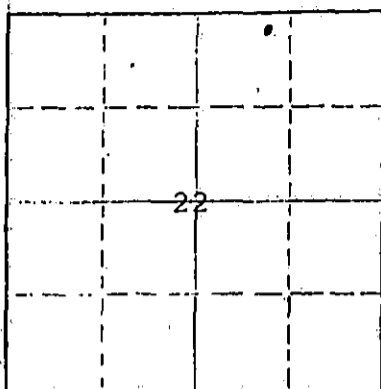

Locate well correctly on above
Section Plat

Hodgeman County, Sec. 22, Twp 22S, Rge. (E) 25 (W)
Location as "NE/CNW/SE/SW" or footage from lines 330' FN & 982' FWL of NE/4
Lease Owner Kewanee Oil Company
Lease Name Red Well No. 1
Office Address Box 2093, Wichita, Kansas
Character of Well (completed as Oil, Gas or Dry Hole) oil
Date well completed 2-12-19 58
Application for plugging filed 5-28-19 74
Application for plugging approved 5-29-19 74
Plugging commenced 5-30-19 74
Plugging completed 6-12-19 74
Reason for abandonment of well or producing formation day

If a producing well is abandoned, date of last production 1-1-19 72
Was permission obtained from the Conservation Division or its agents before plugging was commenced? yes

Name of Conservation Agent who supervised plugging of this well Edgar J. Eves
Producing formation Mississippi Depth to top 4603 Bottom 4703 Total Depth of Well 4703 Feet
Show depth and thickness of all water, oil and gas formations.

OIL, GAS OR WATER RECORDS

CASING RECORD

FORMATION	CONTENT	FROM	TO	SIZE	PUT IN	PULLED OUT
Mississippi	oil	4603		8-5/8	551	none
				5-1/2	4690	2432

Describe in detail the manner in which the well was plugged, indicating where the mud fluid was placed and the method or methods used in introducing it into the hole. If cement or other plugs were used, state the character of same and depth placed, from _____ feet to _____ feet for each plug set.

Plugged back bottom with sand to 4560'.
Dumped 5 sacks cement with bailer.
Pumped 5 sacks gel, 135 sacks cement &
5 sacks gel. Released plug and plugged
with 30 sacks cement, 5 sacks gel and
10 sacks cement to cellar.

RECEIVED
STATE CORPORATION COMMISSION
AUG 23 1974
CONSERVATION DIVISION
Wichita, Kansas

(If additional description is necessary, use BACK of this sheet)

Name of Plugging Contractor Southwest Casing Pulling Company
Address Great Bend, Kansas

STATE OF _____ Kansas COUNTY OF Sedgwick, ss.
B. J. Patton (employee of owner) or (owner) of the above-described
above-described well as filed and that the same are true and correct. So help me God.

(Signature) *B. J. Patton*
Box 2093, Wichita, Kansas 67201 (Address)

Sworn to before me this 22nd day of August, 1974

My commission expires 8-10-75
Billie Oden Notary Public

