


Give All Information Completely  
Make Required Affidavit  
Mail or Deliver Report to:  
Conservation Division  
State Corporation Commission  
211 No. Broadway  
Wichita, Kansas

WELL PLUGGING RECORD

Hodgeman County. Sec. 6 Twp. 22S Rge. 26W (~~EX~~) (W)  
Location as "NE/CNW/SW" or footage from lines C SE NE  
Lease Owner D. R. Lauck Oil Company, Inc.  
Lease Name Schlereth Well No. 1  
Office Address 301 S. Broadway, Wichita, Kansas  
Character of Well (completed as Oil, Gas or Dry Hole) Dry Hole  
Date well completed November 12, 19 63  
Application for plugging filed November 12, 19 63  
Application for plugging approved November 12, 19 63  
Plugging commenced November 12, 19 63  
Plugging completed November 12, 19 63  
Reason for abandonment of well or producing formation Dry Hole

NORTH

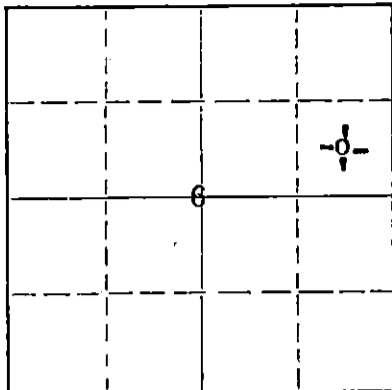

Locate well correctly on above  
Section Plat

If a producing well is abandoned, date of last production \_\_\_\_\_ 19\_\_\_\_  
Was permission obtained from the Conservation Division or its agents before plugging was commenced? Yes

Name of Conservation Agent who supervised plugging of this well Hugh Scott  
Producing formation \_\_\_\_\_ Depth to top \_\_\_\_\_ Bottom \_\_\_\_\_ Total Depth of Well 5154 Feet  
Show depth and thickness of all water, oil and gas formations.

OIL, GAS OR WATER RECORDS

CASING RECORD

FORMATION	CONTENT	FROM	TO	SIZE	PUT IN	PULLED OUT
		0'	298'	8-5/8"	298'	None

Describe in detail the manner in which the well was plugged, indicating where the mud fluid was placed and the method or methods used in introducing it into the hole. If cement or other plugs were used, state the character of same and depth placed, from \_\_\_\_\_ feet to \_\_\_\_\_ feet for each plug set.

5154'-700' Mud  
700'-696' Plug  
696'-656' Cement, 25 sacks  
656'-290' Mud  
290'-286' Plug  
286'-246' Cement, 25 sacks  
246'- 40' Mud  
40'- 36' Plug  
36'- 6' Cement, 15 sacks (Bottom of Cellar)

RECEIVED  
STATE CORPORATION COMMISSION

NOV 19 1963

11-19-63

CONSERVATION DIVISION  
Wichita, Kansas

(If additional description is necessary, use BACK of this sheet)

Name of Plugging Contractor Globe Cementing Co.  
Address Great Bend, Kansas

STATE OF KANSAS, COUNTY OF SEDGWICK, ss.  
John H. Knightley (employee of owner) or (owner or operator) of the above-described

well, being first duly sworn on oath, says: That I have knowledge of the facts, statements, and matters herein contained and the log of the above-described well as filed and that the same are true and correct. So help me God.

(Signature) John H. Knightley  
301 S. Broadway, Wichita, Kansas  
(Address)

SUBSCRIBED AND SWORN TO before me this 18th day of November, 19 63.

My commission expires March 12, 1967

Stella J. Lipp  
Notary Public.



D. R. Lauck Oil Company, Inc.

15-083-10149-0000

Schlereth #1

C SE NE Sec. 6-22S-26W  
Hodgeman County, Kansas

**RECEIVED**  
STATE CORPORATION COMMISSION

Commenced: October 22, 1963  
Completed: November 12, 1963

NOV 19 1963

Casing Record: 298' 8-5/8" Cemented with 190 sacks Cement,  
4 sacks Calcium Chloride.

CONSERVATION DIVISION  
Wichita, Kansas

Elevation: GL 2467; DF 2469; KB 2471.

Drillers Log Tops

		Sample	Schlumberger
Clay	50		
Shale	360	Heebner 3807-1336	3806-1336
Sand	430	Toronto 3830-1359	3828-1357
Shale	950	Lansing 3853-1382	3853-1382
Red Bed	1070	Base-Kansas City 4255-1784	4254-1783
Chalk	1095	Marmaton 4264-1793	4263-1792
Red Bed	1160	Cherokee Shale 4429-1958	4430-1959
Sand	1375	Sandy Conglomerate 4488-2017	4488-2017
Red Bed & Shale	1570	Mississippian 4495-2024	4512-2041
Shale & Lime	1790	Misener Sand 4916-2445	4915-2444
Shale, Shells & Red Bed	1830	Viola 4923-2452	4923-2452
Sand	1850	Simpson Sand 5106-2635	5105-2634
Shale, Shells & Red Bed	2100	Arbuckle 5112-2641	5114-2643
Shale & Shells	2345	Total Depth 5154-2683	5154-2683
Shale & Lime	2480		
Shale	2540		
Lime	2600		
Lime & Shale	2839		
Shale & Lime	3045		
Lime & Shale	3225		
Shale & Lime	3330		
Shale & Shells	3400		
Lime & Shale	3555		
Shale & Lime	3645		
Lime & some Chalk	3730		
Lime & Shale	3815		
Shale & Lime	3875		
Lime, cherty	3930		
Lime	4031		
Lime, cherty	4085		
Lime	4293		
Lime, cherty	4330		
Lime	4525		
Lime & Chert	4555		
Lime	4567		
Lime, cherty	4605		
Lime & Chert	4655		
Lime & Shale	4708		
Lime & Chert	4756		
Lime, some cherty	4778		
Lime	4792		
Chert	4808		
Chert & Lime	4839		
Lime	4852		
Chert & Lime	4886		
Lime & Chert, some chalky	4903		
Lime	4944		
Lime, cherty & chalky	4980		
Lime	5027		
Chert & Lime	5055		
Lime	5154		

DST #1 (M) 4498-4555, open 1 hr. w/fair blow.  
 Recovered 660' salt water.  
 ISIP 1370#/30 min.  
 FSIP 1360#/30 min.  
 IFP 70#  
 FFP 330#

DST #2 (S) 4914-4944, open 1 hr. w/weak blow.  
 Recovered 70' drilling mud.  
 ISIP 1464#/30 min.  
 FSIP 1152#/30 min.  
 IFP 38#  
 FFP 53#

D&A

RTD