

STATE OF KANSAS  
STATE CORPORATION COMMISSION

WELL PLUGGING RECORD

Give All Information Completely  
Make Required Affidavit  
Mail or Deliver Report to:  
Conservation Division  
State Corporation Commission  
800 Bitting Building  
Wichita, Kansas

Finney County, Sec. 30 Twp. 22 Rge. 30W (E) (W)

Location as "NE/CNW/SW" or footage from lines SW SW SW

Lease Owner Bennett & Roberts Drilling Co.

Lease Name Oetken Well No. 1

Office Address Russell, Ks.

Character of Well (completed as Oil, Gas or Dry Hole) Dry Hole

Date well completed 3/31 19 56

Application for plugging filed 3/31 verbally 19 56

Application for plugging approved 3/31 verbally 19 56


Plugging commenced 3/31 19 56

Plugging completed 3/31 19 56

Reason for abandonment of well or producing formation

If a producing well is abandoned, date of last production 19

Was permission obtained from the Conservation Division or its agents before plugging was commenced? Yes

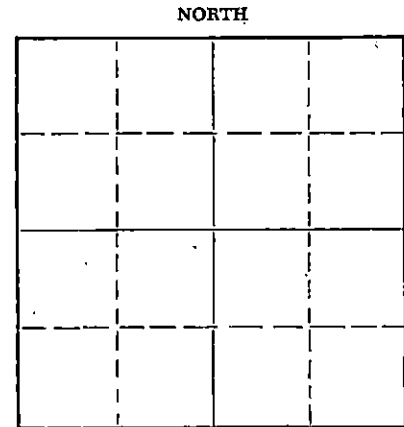

Locate well correctly on above Section Plat

Name of Conservation Agent who supervised plugging of this well R. A. Rives

Producing formation Depth to top Bottom Total Depth of Well 4900 Feet

Show depth and thickness of all water, oil and gas formations.

OIL, GAS OR WATER RECORDS

CASING RECORD

FORMATION	CONTENT	FROM	TO	SIZE	PUT IN	PULLED OUT
				10 3/4"	286'	None

Describe in detail the manner in which the well was plugged, indicating where the mud fluid was placed and the method or methods used in introducing it into the hole. If cement or other plugs were used, state the character of same and depth placed, from feet to feet for each plug set.

Filled hole with heavy mud to 280' w/ 1/2 sack  
hulls, Halliburton plug and 20 sx cement.  
Hole open from 240' to surface so that farmer  
may make irrigating well of it.

(If additional description is necessary, use BACK of this sheet)

Name of Plugging Contractor

Address

STATE OF KANSAS, COUNTY OF RUSSELL, ss.

Harold Wurst (employee of owner) or (owner or operator) of the above-described

well, being first duly sworn on oath, says: That I have knowledge of the facts, statements, and matters herein contained and the log of the above-described well as filed and that the same are true and correct. So help me God.

(Signature) Harold Wurst

Russell, Ks.

(Address)

SUBSCRIBED AND SWORN to before me this 2nd day of April, 19 56

My commission expires 6/17/58

Notary Public.

PLUGGING  
FILE SEC. 30 T. 22 R. 30W  
BOOK PAGE 50 LINE 21

RECEIVED  
STATE CORPORATION COMMISSION  
CONSERVATION DIVISION  
Wichita, Kansas

44-56

Bennett & Roberts Drilling Co.  
Oetken #1

SW SW SW 30--22-30W  
Finney County, Ks.

R.T.D. 4900'

Casing Record  
10 3/4" Set @ 286' w/200 sx cmt

Commenced 3/7/56  
Completed 3/31/56

----- Figures Indicate Bottom of Formation -----

Surface Soil	35
Sand	125
Sand	145
Yellow Clay	275
Shale & Lime	286
Shale, Lime, Shells & Sand	945
Blue Shale	1300
Red rock, Shale & Shells(Gyp.)	1495
Red Shale, Shells & Shale	1550
Red Bed & Shale	1730
Shale & Lime Shells	2000
Shale & Shells	2080
Anhydrite	2120
Shale & Shells	2539
Shale & Lime	2639
Lime, Shale & Sand	2729
Sand & Lime	2810
Shale & Lime	3030
Lime	3167
Shale & Lime	3220
Lime	3274
Lime & Shale	3805
Lime	3923
Shale & Chalky Lime	4001
Lime	4515
Lime & Shale	4546
Lime	4676
Lime & Shale	4709
Lime	4745
Lime & Sand	4755
Lime	4814
Sandy Lime	4825
Lime	4900

STATE OF KANSAS)  
RUSSELL COUNTY ) SS.

I hereby certify that the above information is correct to the best of my knowledge.

BENNETT & ROBERTS DRILLING CO.

By *[Signature]*

Subscribed and sworn to before me this 2nd day of April, 1956.

*[Signature]*  
Notary Public

My Commission Expires 6/17/58

**PLUGGING**  
FILE SEC 30 T 22 R 30W  
BOOK PAGE 50 LINE 21

RECEIVED  
STATE CORPORATION

APR 1956  
CONSERVATION DIVISION