


STATE OF KANSAS
STATE CORPORATION COMMISSION
CONSERVATION DIVISION
P. O. BOX 17027
WICHITA, KANSAS 67217

WELL PLUGGING RECORD

Kingman County, Sec. 19 Twp. 30 Rge. (E) 9 (W)
Location as "NE/CNWKSW2" or footage from lines C SW SW
Lease Owner Mallonee-Mahoney, Inc.
Lease Name Piehl Trust Well No. 1
Office Address 925 Sutton Place, Wichita, Kansas 67202
Character of Well (completed as Oil, Gas or Dry Hole) oil
Date well completed March 29 1975
Application for plugging filed Sept. 29 1975
Application for plugging approved 1975
Plugging commenced Oct. 7 1975
Plugging completed Oct. 13 1975
Reason for abandonment of well or producing formation depleted

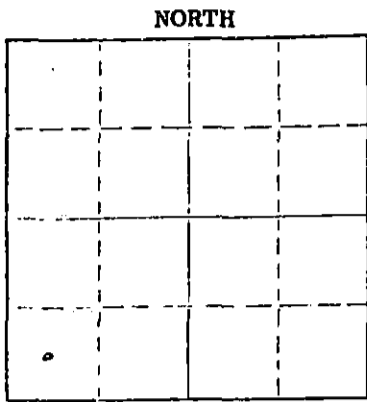

Locate well correctly on above Section Plat

If a producing well is abandoned, date of last production 19
Was permission obtained from the Conservation Division or its agents before plugging was commenced? yes

Name of Conservation Agent who supervised plugging of this well G. R. Biberstein
Producing formation _____ Depth to top _____ Bottom _____ Total Depth of Well 4420 Feet
Show depth and thickness of all water, oil and gas formations.

OIL, GAS OR WATER RECORDS

CASING RECORD

FORMATION	CONTENT	FROM	TO	SIZE	PUT IN	PULLED OUT
			264'	8 5/8"	264'	none
			4400'	4 1/2"	4400'	3849.02

Describe in detail the manner in which the well was plugged, indicating where the mud fluid was placed and the method or methods used in introducing it into the hole. If cement or other plugs were used, state the character of same and depth placed, from _____ feet to _____ feet for each plug set.

Pumped 50 sacks of cement to 4350'.
Set 10' rock bridge at 360'. Plugged well with 6 yards of ready mix cement.

RECEIVED
STATE CORPORATION COMMISSION
10-16-75
OCT 16 1975

(If additional description is necessary, use BACK of this sheet)
Name of Plugging Contractor PIPE PULLERS, INC.
Address Box 128, Ellinwood, Kansas 67526
CONSERVATION DIVISION
Wichita, Kansas

STATE OF KANSAS COUNTY OF BARTON ss.
Evelyn Roth (employee of owner) or (owner or operator) of the above-described well, being first duly sworn on oath, says: That I have knowledge of the facts, statements, and matters herein contained and the log of the above-described well as filed and that the same are true and correct. So help me God.

(Signature) Evelyn Roth
Ellinwood, Kansas (Address)

SUBSCRIBED AND SWORN TO before me this 15th day of October, 1975

My commission expires _____
JENNY KASSELMAN
NOTARY-PUBLIC
BARTON COUNTY, KANSAS
MY COMM. EXP. JULY 16, 1978

Jerry Kasselmann
Notary Public.

GABBERT-JONES, INC.
WICHITA, KANSAS
DRILLERS' WELL LOG

Piehl Estate
C-SW-SW Sec 19-308-9W
Kingman County Kansas

Commenced: 3-16-75

Completed: 3-29-75

OPERATOR: MALLONEE-MAHONEY

Depth		Formation	Remarks
From	To		
0	140	Shale-Sand	Ran 6 jts of New 20#
140	266	RedShale-Shells	8 5/8" csg @ 264' Cemented
266	950	Redbed-Shale	w/250 sks Common 3% CC
950	1735	Shale-Shells	P.D. @ 3:15 a.m. 3-17-75
1735	1805	Shale-Lime	
1805	2040	Lime-Shale	
2040	2134	Shale-Lime	
2134	2820	Lime-Shale	
2820	3265	Shale-Lime	
3265	3730	Lime-Shale	
3730	4225	Lime	
4225	4280	Shale-Lime	Ran 134 jts of used 4 1/2"
4280	4380	Lime-Shale	set @ 4400' Cemented w/
4380	4410	Shale-Miss	125 sks 50/50 Posmix
4410	4420	Chat	PD @ 12:30 a.m. 3-29-75
	4420 TD		

I, James S. Sutton II, certify this is a correct copy of the Drillers' Log for the well drilled C-SW-SW Sec 19-308-9W, Kingman County Kansas to the best of my knowledge and belief.

RECEIVED
STATE CORPORATION COMMISSION

SEP 30 1975

James S. Sutton II
JAMES S. SUTTON II

STATE OF KANSAS)
) SS. CONSERVATION DIVISION
COUNTY OF SEDGWICK) Wichita, Kansas

Before me, the undersigned, a Notary Public within and for said County and State, on this 2nd day of April, 1975, personally appeared James S. Sutton II to me personally known to be the identical person who executed the within and foregoing instrument and acknowledged to me that he executed the same as his free and voluntary act and deed for the uses and purposes therein set forth.

IN WITNESS WHEREOF, I have hereunto set my hand and official seal the day and year last above written.

Marjorie Hall
MARJORIE HALL-NOTARY PUBLIC

My Commission Expires: November 29th, 1975.

