


STATE OF KANSAS
STATE CORPORATION COMMISSION

Give All Information Completely
Make Required Affidavit
Mail or Deliver Report to:
Conservation Division
State Corporation Commission
211 No. Broadway
Wichita, Kansas

WELL PLUGGING RECORD

NORTH

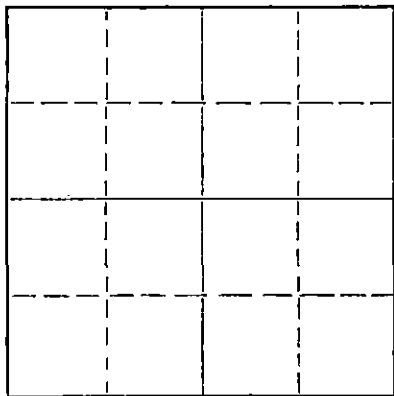

Locate well correctly on above
Section Plat

Kingman County. Sec. 21 Twp. 30S Rge. (E) 9 (W)
Location as "NE/CNW/SE/SW" or footage from lines C NE NE NW
Lease Owner Sunray Mid-Continent Oil Company
Lease Name Hawley Well No. 1
Office Address Box # 788, Great Bend, Kansas
Character of Well (completed as Oil, Gas or Dry Hole) Dry Hole
Date well completed February 28, 19 58
Application for plugging filed March 3, 19 58
Application for plugging approved March 5, 19 58
Plugging commenced February 28, 19 58
Plugging completed February 28, 19 58
Reason for abandonment of well or producing formation _____

If a producing well is abandoned, date of last production _____ 19____
Was permission obtained from the Conservation Division or its agents before plugging was commenced? Yes

Name of Conservation Agent who supervised plugging of this well Fred Hampel
Producing formation _____ Depth to top _____ Bottom _____ Total Depth of Well 4400 Feet
Show depth and thickness of all water, oil and gas formations.

OIL, GAS OR WATER RECORDS

CASING RECORD

FORMATION	CONTENT	FROM	TO	SIZE	PUT IN	PULLED OUT
				8 5/8"	308	None

Describe in detail the manner in which the well was plugged, indicating where the mud fluid was placed and the method or methods used in introducing it into the hole. If cement or other plugs were used, state the character of same and depth placed, from _____ feet to _____ feet for each plug set.

Filled hole w/ drlg mud, set halliburton plug at 260' with 1/3 sack hull & 30 sacks cement. Mud to 35', 1/3 sack hulls & 30 sacks cement, cement to surface, plugging completed.

Well log attached.

RECEIVED
STATE CORPORATION COMMISSION
MAR 8 1958
3-8-58
CONSERVATION DIVISION
Wichita, Kansas

(If additional description is necessary, use BACK of this sheet)
Name of Plugging Contractor Halliburton Oil Well Cementing Co.
Address _____

STATE OF KANSAS, COUNTY OF BARTON, ss.
N. E. Montgomery (employee of owner) or (owner/contractor) of the above-described well, being first duly sworn on oath, says: That I have knowledge of the facts, statements, and matters herein contained and the log of the above-described well as filed and that the same are true and correct. So help me God.

(Signature) N. E. Montgomery
Box # 788, Great Bend, Kansas
(Address)

SUBSCRIBED AND SWORN TO before me this 7 day of March, 19 58

[Signature]

Notary Public.

My commission expires Dec. 24, 1960

PLUGGING
FILE SEC. 21T 30R 9W
BOOK PAGE 86 U = 40

Sunray Mid-Continent Oil Company
Tulsa, Oklahoma

Tulsa, Oklahoma
March 3, 1958

CONTRACTOR: Stickle Drilling Company
Drilling Commenced: February 11, 1958
Drilling Completed: February 28, 1958

Hawley #1 NW/4 Section
21-30S-9W, Kingman
County, Kansas.

DRILLERS LOG

Depth Figures indicate base of formation:

Surface	0
Clay & Sand	40
Sand	110
Shale & Shells	960
Shale & Anhydrite Streak	1210
Shale & Shells	1400
Lime & Shale	2290
Shale & Lime	2715
Lime	2735
Shale & Lime	2835
Lime & Shale	3010
Shale & Lime	3090
Lime & Shale	3360
Lime	3400
Lime & Shale	3550
Shale & Lime	3635
Lime & Shale	3715
Lime	4155
Lime & Shale	4290
Lime & Shale With Chert	4320
Mississippi Chert	4339
Chat	4392
Lime	4400 TD

I, Frank E. Stickle, hereby certify the above to be a true and complete Drillers Log of Sunray Mid-Continent Oil Company's P. Hawley #1 NW/4 Section 21-30S-9W, Kingman County, Kansas.

Frank E. Stickle
Frank E. Stickle

William T. Bonham
Notary Public

February 13, 1960
My Commission Expires

PLUGGING
FILE - SEC 21 T 30 R 9W
PAGE 86 LINE 9D

RECEIVED
STATE CORPORATION COMMISSION
MAR 8 1958
CONSERVATION DIVISION
Wichita