


STATE OF KANSAS  
STATE CORPORATION COMMISSION

WELL PLUGGING RECORD

Give All Information Completely  
Make Required Affidavit  
Mail or Deliver Report to:  
Conservation Division  
State Corporation Commission  
211 No. Broadway  
Wichita, Kansas

Kingman County, Sec. 21 Twp. 30S Rge. (E) 9 (W)

NORTH

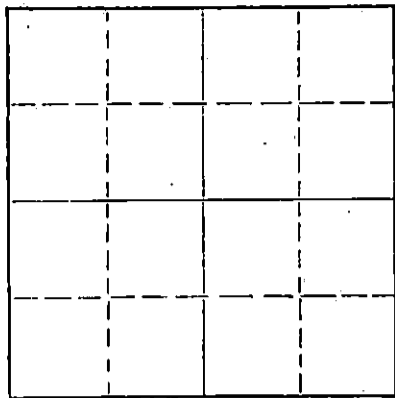

Locate well correctly on above  
Section Plat

Location as "NE/CNW/SW" or footage from lines C NW/4 SE/4  
Lease Owner Cooperative Refinery Association  
Lease Name Swingle "A" Well No. 1  
Office Address Box 765 Great Bend, Kansas  
Character of Well (completed as Oil, Gas or Dry Hole) dry hole  
Date well completed May 16 19 60  
Application for plugging filed \_\_\_\_\_ 19 \_\_\_\_\_  
Application for plugging approved May 15 - verbal 19 60  
Plugging commenced May 15 19 60  
Plugging completed May 15 19 60  
Reason for abandonment of well or producing formation dry hole

If a producing well is abandoned, date of last production \_\_\_\_\_ 19 \_\_\_\_\_  
Was permission obtained from the Conservation Division or its agents before plugging was commenced? yes

Name of Conservation Agent who supervised plugging of this well Fred W. Hampel  
Producing formation \_\_\_\_\_ Depth to top \_\_\_\_\_ Bottom \_\_\_\_\_ Total Depth of Well 4362 Feet  
Show depth and thickness of all water, oil and gas formations.

OIL, GAS OR WATER RECORDS

CASING RECORD

FORMATION	CONTENT	FROM	TO	SIZE	PUT IN	PULLED OUT
				8 5/8	250	-0-

Describe in detail the manner in which the well was plugged, indicating where the mud fluid was placed and the method or methods used in introducing it into the hole. If cement or other plugs were used, state the character of same and depth placed, from \_\_\_\_\_ feet to \_\_\_\_\_ feet for each plug set.

Filled hole with heavy mud to 240'. Set bridge plug at 240' with 1/4 sx. hulls. Dumped 15 sacks cement through drill pipe on plug. Filled with heavy mud to 35', set bridge plug at 35' with 1/4 sx. Dumped 10 sacks cement on plug to cellar.

RECEIVED  
STATE CORPORATION COMMISSION  
MAY 20 1960  
CONSERVATION DIVISION  
Wichita, Kansas

Name of Plugging Contractor Shields Drig. Company (If additional description is necessary, use BACK of this sheet)  
Address Russell, Ks.

STATE OF KANSAS, COUNTY OF BAERTON, ss.  
John H. Nation (employee of owner) or (owner or operator) of the above-described well, being first duly sworn on oath, says: That I have knowledge of the facts, statements, and matters herein contained and the log of the above-described well as filed and that the same are true and correct. So help me God.

(Signature) John H. Nation  
Box 765 Great Bend, Ks.  
(Address)

SUBSCRIBED AND SWORN TO before me this 18 day of May, 19 60

My commission expires November 8, 1960  
Betty S. Edman Notary Public.



## DRILLERS LOG

Swingle A #1

Elevation: 1648 D.F.

Loc: C NW/4 SE/4

Casing: 8 5/8" @ 250' w/ 150

Sec: 21-30S-9W

Comm: 5-2-60 Comp: 5-16-60

Kingman County, Kansas

Operator: Cooperative Refinery Ass'n.

R.T.D. 4362'.

Contractor: Shields Drlg. Company

<u>From</u>	<u>To</u>	<u>Formation</u>
0	250	Surface
250	890	Shale, shells, redbed
890	1220	Shale and shells
1220	1245	Anhydrite streaks
1245	1540	Shale, shells, lime
1540	1960	Lime and shale
1960	2095	Broken lime and shale
2095	3125	Lime and shale
3125	3140	Shale
3140	3375	Lime
3375	3460	Lime and shale
3460	3505	Shale
3505	3515	Sand and shale
3515	3546	Sandy lime
3546	3626	Shale and lime
3626	4062	Lime
4062	4080	Lime and shale
4080	4190	Lime
4190	4205	Shale and lime
4205	4280	Shale, lime, sand, chert
4280	4287	Shale with lime
4287	4307	Lime w/ chert
4307	4332	Chert
4332	4362	Lime w/ chert
4362		R.T.D.

**RECEIVED**  
STATE CORPORATION COMMISSION

MAY 20 1960

CONSERVATION DIVISION  
Wichita, Kansas

(STATE OF KANSAS )

(COUNTY OF BARTON)

I hereby certify that the above is a true and correct copy of the log on the Swingle "A" #1 well, located C NW/4 SE/4 of Section 21-30S-9W, Kingman County, Kansas.

John H. Nation

Subscribed and sworn to before me this 18 day of May 1960.

Petty S. Edman

My commission expires: November 8, 1960