


STATE OF KANSAS  
STATE CORPORATION COMMISSION

15-009-05584-0000  
WELL PLUGGING RECORD

Give All Information Completely  
Make Required Affidavit  
Mail or Deliver Report to:  
Conservation Division  
State Corporation Commission  
800 Bitting Building  
Wichita, Kansas

Barton County. Sec. 26 Twp. 16S Rge. 11W (E) (W)  
Location as "NE/CNW/SW" or footage from lines SE/4 SE/4 SW/4  
Lease Owner The El Dorado Refining Co.  
Lease Name Kraft "A" Well No. 4  
Office Address Box 551 - El Dorado, Kansas  
Character of Well (completed as Oil, Gas or Dry Hole) Dry Hole  
Date well completed 12-20-52 19  
Application for plugging filed 12-23-52 19  
Application for plugging approved 12-26-52 19  
Plugging commenced 1-12-53 19  
Plugging completed 1-21-53 19  
Reason for abandonment of well or producing formation Dry Hole  
If a producing well is abandoned, date of last production \_\_\_\_\_ 19  
Was permission obtained from the Conservation Division or its agents before plugging was commenced? Yes

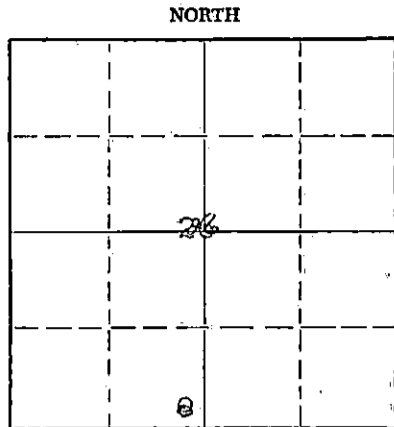

Locate well correctly on above Section Plat

Name of Conservation Agent who supervised plugging of this well Mr. C. D. Stough  
Producing formation Arbuckle Depth to top 3390 Bottom \_\_\_\_\_ Total Depth of Well 3400 Feet  
Show depth and thickness of all water, oil and gas formations.

OIL, GAS OR WATER RECORDS

CASING RECORD

FORMATION	CONTENT	FROM	TO	SIZE	PUT IN	PULLED OUT
				8-5/8"	316'	000'
				5 1/2"	3387'	2956' 3"

Describe in detail the manner in which the well was plugged, indicating where the mud fluid was placed and the method or methods used in introducing it into the hole. If cement or other plugs were used, state the character of same and depth placed, from \_\_\_\_\_ feet to \_\_\_\_\_ feet for each plug set.

Filled hole with sand to 3375' and ran  
5 sacks of cement at 3375'  
Mudded to 300'  
Set bridge and ran 20 sacks of cement at 300'  
Mudded to 30'  
Run 10 sacks of cement to cap.

RECEIVED  
STATE CORPORATION COMMISSION

FEB 4 - 1953

02-04-53

CONSERVATION DIVISION  
Wichita, Kansas

(If additional description is necessary, use BACK of this sheet)

Name of Plugging Contractor C. E. Shull Casing Pulling Company  
Address Box 558 - Great Bend, Kansas

STATE OF KANSAS, COUNTY OF RUSSELL, ss.  
Levi B. Sherman (employee of owner) or (owner or operator) of the above-described well, being first duly sworn on oath, says: That I have knowledge of the facts, statements, and matters herein contained and the log of the above-described well as filed and that the same are true and correct. So help me God.

(Signature) Levi B. Sherman  
Box 209 - Russell, Kansas  
(Address)

SUBSCRIBED AND SWORN TO before me this 3 day of February, 19 53

Hubert B. Jones  
Notary Public.

My commission expires 8-13-55

PLUGGING  
FILE SEC 26T-16-R-1124  
BOOK PAGE 68 LINE 31

WELL LOG - - - - - KRAFT "A" # 4

Location - SE/4 SE/4 SW/4 Section 26-16S-11W, Barton County, Kans.

Owner - The El Dorado Refining Co.  
 Rotary Drilling Contractor - Sterling Drilling Company  
 Cable Tools Contractor -

Commenced - 12-3-52  
 Completed - 12-13-52 (w/r)  
 (w/c.t.)

Total Depth - 3390' (w/r) 3387 D. F.  
 - 3400' (w/c.t.) D. F.

LOG

CASING RECORD

0- 70 Shale and Shells  
 70- 320 Shale and Red Bed  
 320- 550 Sand and Shale  
 550- 730 Red Bed  
 730- 755 Anhydrite  
 755-1580 Shale and Shells  
 1580-1890 Lime and Shale  
 1890-2060 Lime  
 2060-2240 Shale and Lime  
 2240-2430 Shale  
 2430-2770 Shale and Lime  
 2770-2940 Lime  
 2940-3080 Shale and Lime  
 3080-3255 Lime  
 3255-3380 Lime and Shale  
 3380-3386 Conglomerate  
 3386-3390 Arbuckle Lime

316' of 8-5/8" Surface Pipe  
 Cemented with 150 Sacks Cement  
 3387' of 5 1/2" Casing  
 Cemented with 50 Sacks Cement

PRODUCTION: D & A  
 ELEVATION: 1928 D. F.  
 FORMATION TOPS: D. F.  
 Heebner. 2968  
 Br. ls. 3068  
 Lansing 3083  
 Cg. 3369  
 Arb. 3383

DST 3384-87, op. 1 hr. wk. blow thruout, rec. 70' oil & H OCM, BHP 150#  
 D. P. & C. O. to R. T. D. 3 GOPH Perf (4ks) 3385-87, 500 acid. F. U.  
 80' oil & 20' wtr/12 hrs. D. D. to 3400 T. D. HFV.

REC  
 STATE CORP.

CONSERV.  
 Wichita

PLUGGING  
 FILE SEC 26 T 16 R 11W  
 BOOK PAGE 68 LINE 31