


STATE OF KANSAS
STATE CORPORATION COMMISSION

15-009-05581-0000
WELL PLUGGING RECORD

Give All Information Completely
Make Required Affidavit
Mail or Deliver Report to:
Conservation Division
State Corporation Commission
800 Bitting Building
Wichita, Kansas

Barton County. Sec. 26 Twp. 16 Rge. 11 (E) W (W)
Location as "NE/CNW $\frac{1}{4}$ /SW $\frac{1}{4}$ " or footage from lines Northwest Corner
Lease Owner Nadel and Gussman
Lease Name Kraft Well No. 1
Office Address 703 Union National Bank Bldg. Wichita 2, Kans.
Character of Well (completed as Oil, Gas or Dry Hole) Dry
Date well completed 10-26-50
Application for plugging filed 10-26-50
Application for plugging approved 10-26-50
Plugging commenced 10-26-50
Plugging completed 10-26-50
Reason for abandonment of well or producing formation Dry
If a producing well is abandoned, date of last production No 19
Was permission obtained from the Conservation Division or its agents before plugging was commenced? Yes

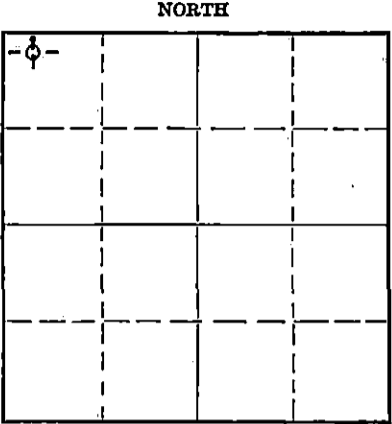

Locate well correctly on above Section Plat

Name of Conservation Agent who supervised plugging of this well C. D. Stough
Producing formation _____ Depth to top _____ Bottom _____ Total Depth of Well 3425 Feet
Show depth and thickness of all water, oil and gas formations.

OIL, GAS OR WATER RECORDS

CASING RECORD

Formation	Content	From	To	Size	Put In	Pulled Out
				8-5/8"	270	None

Describe in detail the manner in which the well was plugged, indicating where the mud fluid was placed and the method or methods used in introducing it into the hole. If cement or other plugs were used, state the character of same and depth placed, from _____ feet to _____ feet for each plug set.

Hole filled with heavy mud 3425 to 260' - 15 sacks cement
Mud 215 to 40' - 10 sacks cement

RECEIVED
STATE CORPORATION COMMISSION
NOV 1 1950 11-01-50
CONSERVATION DIVISION
Wichita, Kansas

(If additional description is necessary, use BACK of this sheet)
Correspondence regarding this well should be addressed to Nadel and Gussman
Address P. O. Box 309, Tulsa, Oklahoma

STATE OF KANSAS, COUNTY OF SEDGWICK, ss.
L. C. Hay (employee of owner) or (owner or operator) of the above-described well,
being first duly sworn on oath, says: That I have knowledge of the facts, statements, and matters herein contained and the log of the above-described well as filed and that the same are true and correct. So help me God.

(Signature) L. C. Hay
703 Union National Bank Bldg. Wichita (Address)

SUBSCRIBED AND SWORN to before me this 30th day of October, 1950
Notary Public.

My commission expires Nov. 3, 1952 4-50-10M

PLUGGING
FILE SEC. 26 T. 16 R. 11 W
BOOK PAGE 39 LINE 10

WELL LOG

Nadel and Gussman

Kraft No. 1

NW NW NW Sec. 26-16-11W
Barton County, Kansas

Commenced 10-15-50
Completed 10-25-50

Casing Record:
270' 8 1/2", Cem W/200' sex

Formations	Depth
Surface	270
Shale and shells	390
Sand and shale	520
Shale and red bed	746
Anhydrite	785
Shale and shells	1620
Broken Lime	1655
Lime and Shale	2155
Shale and shells	2720
Broken Lime	2765
Lime and shale	2844
Lime	3354
Conglomerate	3398
Sand	3402
Arbuckle	3425

Geological Tops

Heebner Shale	2964
Toronto Limestone	2985
Brown Limestone	3060
Lansing	3079
Conglomerate	3373
Arbuckle	3402
D&A	

STATE OF KANSAS)
COUNTY OF SEDGWICK)

SS:

RECEIVED
STATE CORPORATION DIVISION
NOV - 1 1950
CONSERVATION DIVISION
Wichita, Kansas

L. C. Hay of lawful age, being duly sworn states that the above formations and depths are true and correct as taken from the daily drilling log of the Kraft No. 1 well in the NW NW NW Sec. 26-16-11W, Barton County, Kansas.

L. C. Hay

Subscribed and sworn to before me this 30th day of October, 1950

My commission expires Nov. 3, 1952

John B. Babb
Notary Public

PLUGGING
NW NW NW SEC 26-16-11W
BOOK PAGE 39 LINE 10