


15-009-15030-0000
WELL PLUGGING RECORD

Give All Information Completely
Make Required Affidavit
Mail or Deliver Report to:
Conservation Division
State Corporation Commission
800 Bitting Building
Wichita, Kansas

Barton County, Sec. 26 Twp. 16 Rge. 11 (E) (W)

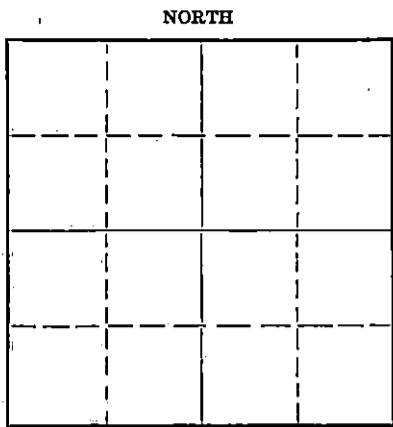

Locate well correctly on above Section Plot

Location as "NE/CNW $\frac{1}{4}$ /SW $\frac{1}{4}$ " or footage from lines NE NW SW
Lease Owner The El Dorado Refining Company
Lease Name Kraft Well No. 3
Office Address Box 209 Russell, Kansas
Character of Well (completed as Oil, Gas or Dry Hole) Oil
Date well completed December 11 19 51
Application for plugging filed June 11 19 56
Application for plugging approved June 12 19 56
Plugging commenced June 23 19 56
Plugging completed June 27 19 56
Reason for abandonment of well or producing formation Insufficient Production
If a producing well is abandoned, date of last production June 22 19 56
Was permission obtained from the Conservation Division or its agents before plugging was commenced? yes

Name of Conservation Agent who supervised plugging of this well Mr. R. M. Brundage Box 283 Hoisington, Kansas
Producing formation Arbuckle Depth to top 3365 Bottom 3370 Total Depth of Well 3376 $\frac{1}{2}$ Feet
Show depth and thickness of all water, oil and gas formations.

OIL, GAS OR WATER RECORDS

CASING RECORD

Formation	Content	From	To	Size	Put In	Pulled Out
				8 5/8"	300	none
				5 1/2"	336 $\frac{1}{2}$	3037.30'

Describe in detail the manner in which the well was plugged, indicating where the mud fluid was placed and the method or methods used in introducing it into the hole. If cement or other plugs were used, state the character of same and depth placed, from _____ feet to _____ feet for each plug set.

Filled hole with sand to 3355'
Run 5 sacks of cement at 3355'
Mudded to 320'
Set rock bridge to 300'
Run 20 sacks of cement at 300'
Mudded to 35'
Set rock bridge to 30'
Run 10 sacks of cement to cap.

(If additional description is necessary, use BACK of this sheet)

Name of Plugging Contractor C. E. Shull Casing Pulling Company
Address Box 558 Great Bend, Kansas

STATE OF KANSAS, COUNTY OF RUSSELL, ss.
LEVI B. SHERMAN (employee of owner) or (owner or operator) of the above-described well, being first duly sworn on oath, says: That I have knowledge of the facts, statements, and matters herein contained and the log of the above-described well as filed and that the same are true and correct. So help me God.

(Signature) Levi B. Sherman
Box 209 Russell, Kansas
(Address)

SUBSCRIBED AND SWORN TO before me this 6th day of July, 19 56.

My commission expires 5 - 9 - 59

Carol J. Milberger
Notary Public.

28-8390-s 6-51-20M

PLUGGING
FILE SEC. 26 T. 16 R. 11w
BOOK PAGE 70 LINE 34

JUL 11 1956
07-09-56
G.C.N.S.
Wichita, Kansas

STERLING DRILLING CO.

STERLING, KANSAS

WELL LOG----- KRAFT #3

Location - NE/4 NW/4 S/4 of Section 26-16s-11w, Barton County, Kansas

OWNER - The El Dorado Refining Company
 ROTARY DRILLING CONTRACTOR - Sterling Drilling Company
 CABLE TOOL CONTRACTOR -

Commenced - 11-23-51

Elevation: 1918 D. F.

Completed - 12-4-51 (w/r)
 (w/c.t.)

Production: 165 BOPD, N.W.

Total Depth - 3370' (w/r)

LOG

0 - 60	Surface Clay and Sand
60 - 305	Shale
305 - 580	Shale and Shells
580 - 730	Red Bed and Shale
730 - 765	Anhydrite
765 - 890	Shale and Red Bed
890 - 1350	Shale and Shells
1350 - 1890	Lime
1890 - 2200	Lime and Shale
2200 - 2380	Shale and Shells
2380 - 2815	Lime and Shale
2815 - 2985	Lime
2985 - 3075	Lime and Shale
3075 - 3365	Lime
3365 - 3370	Arbuckle Lime
3376 1/2	Total Depth

CASING RECORD

300' of 8 5/8" surface pipe, cemented with 175 sacks cement.
 3364' of 5 1/2" O.D. Casing, cemented with 50 sacks cement.

FORMATION TOPS:

Heebner	2955
Toronto	2976
Brown Lime	3058
Lansing	3072
Conglomerate	3355
Arbuckle	3358

D. P. no shows, D. D. 3373, bailed 2/3 BOPH. 500 acid, no reaction.
 D. D. 3376 1/2' 4 BOPH/5 hrs., F. U. 900' OIH/9 hrs.

No Perforations.

COPY

PLUGGING
 FILE SEC 26 T 16 R 11w
 BOOK PAGE 70 LINE 34