

STATE OF KANSAS
STATE CORPORATION COMMISSION

Give All Information Completely
Make Required Affidavit
Mail or Deliver Report to:
Conservation Division
State Corporation Commission
800 Pitting Building
Wichita, Kansas

WELL PLUGGING RECORD

OR 15-009-05582-0000
FORMATION PLUGGING RECORD Strike out upper line when reporting plugging off formations.

Barton County. Sec. 26 Twp. 16S Rge. 11 (E) 11 (W)

Location as "NE $\frac{1}{4}$ NW $\frac{1}{4}$ SW $\frac{1}{4}$ " or footage from lines NW SW SW

Lease Owner The Eldorado Refining Company

Lease Name Kraft Well No. 1

Office Address Eldorado, Kansas

Character of Well (completed as Oil, Gas or Dry Hole) Dry Hole

Date well completed October 24, 19 48

Application for plugging filed October 24, 19 48

Application for plugging approved October 25, 19 48


Plugging commenced October 25, 19 48

Plugging completed October 25, 19 48

Reason for abandonment of well or producing formation Dry Hole

If a producing well is abandoned, date of last production 19

Was permission obtained from the Conservation Division or its agents before plugging was commenced? Yes

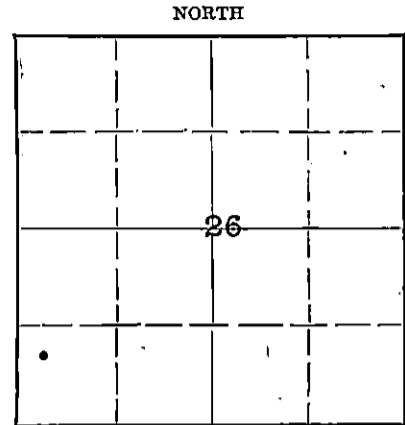

Locate well correctly on above Section Plat

Name of Conservation Agent who supervised plugging of this well C. D. Stough

Producing formation Depth to top Bottom Total Depth of Well 3421 Feet

Show depth and thickness of all water, oil and gas formations.

OIL, GAS OR WATER RECORDS

CASING RECORD

Formation	Content	From	To	Size	Put In	Pulled Out
				8-5/8"	315'	

Describe in detail the manner in which the well was plugged, indicating where the mud fluid was placed and the method or methods used in introducing it into the hole. If cement or other plugs were used, state the character of same and depth placed, from feet to feet for each plug set.

15 Sacks Cement at bottom of surface pipe and
10 Sacks at top.

11-20-48

(If additional description is necessary, use BACK of this sheet)

Correspondence regarding this well should be addressed to The Eldorado Refining Company
Address Eldorado, Kansas

STATE OF Kansas, COUNTY OF Rice, ss.
Rollin Mead (employee of owner) or (owner or operator) of the above-described well,

being first duly sworn on oath, says: That I have knowledge of the facts, statements, and matters herein contained and the log of the above-described well as filed and that the same are true and correct. So help me God.

(Signature) Rollin Mead

Sterling, Kansas (Address)


SUBSCRIBED AND SWORN TO before me this 5th day of November, 19 48.

My Commission Expires August 17, 1949

My commission expires

22-2025 2-48-15M

Notary Public.

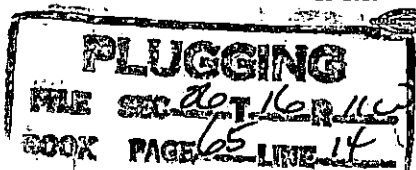

Location - NW SW SW of Section 23-16S-11W; Barton County, Kansas.

Commenced - 10-12-48

Completed - 10-25-48 (w/r) Plugged and Abandoned.

Owner - The Eldorado Refining Company, Eldorado, Kansas

Contractor - Sterling Drilling Company, Sterling, Kansas

Total Depth - 3421' (w/r)

LOG

CASING RECORD

0- 260 Surface
 260- 535 Shale and Shells
 535- 710 Red Bed and Shale
 710- 730 Red Bed
 730- 750 Anhydrite
 750-1515 Shale and Shells
 1515-1885 Shale and Lime
 1885-2155 Lime
 2155-2355 Lime and Shale
 2355-2685 Shale and Shells
 2685-2940 Lime
 2940-3085 Shale and Lime
 3085-3095 Shale
 3095-3370 Lime
 3370-3395 Chert
 3395-3421 Conglomerate

315' 8-5/8" Surface Pipe
Cemented with 175 Sacks Cement

PRODUCTION

None, Dry and Abandoned.

PLUGGING
 FILE SEC 26-16S-11W
 BOOK PAGE 65 LINE 4

RECORDED
 NOV 5 1948
 KANSAS GEOLOGICAL SURVEY