


STATE OF KANSAS  
 STATE CORPORATION COMMISSION  
 Give All Information Completely  
 Make Required Affidavit  
 Mail or Deliver Report to:  
 Conservation Division  
 State Corporation Commission  
 211 No. Broadway  
 Wichita, Kansas

15-009-15028-0000  
**WELL PLUGGING RECORD**

Barton County, Sec. 26 Twp. 16 Rge. (8) 11 (W)  
 Location as "NE/CNW/SW" or footage from lines SW SW Se  
 Lease Owner Colorado Oil & Gas Corporation  
 Lease Name Homolka Well No. 1  
 Office Address Box 1030, Wichita, Kansas  
 Character of Well (completed as Oil, Gas or Dry Hole) Oil  
 Date well completed November 20 19 52  
 Application for plugging filed December 21 19 60  
 Application for plugging approved December 28 19 60  
 Plugging commenced January 11 19 61  
 Plugging completed January 14 19 61  
 Reason for abandonment of well or producing formation depleted.

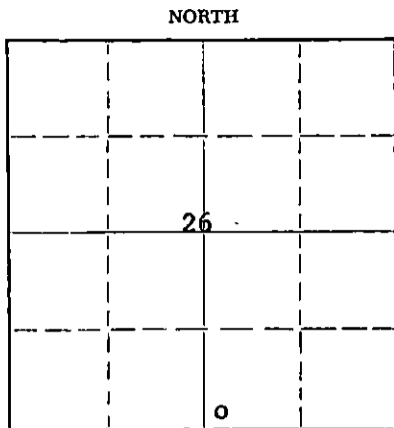

Locate well correctly on above Section Plat

If a producing well is abandoned, date of last production November 26 19 60  
 Was permission obtained from the Conservation Division or its agents before plugging was commenced? yes

Name of Conservation Agent who supervised plugging of this well Don Truan  
 Producing formation Arbuckle Depth to top 3366 Bottom \_\_\_\_\_ Total Depth of Well 3377 Feet  
 Show depth and thickness of all water, oil and gas formations.

OIL, GAS OR WATER RECORDS

CASING RECORD

FORMATION	CONTENT	FROM	TO	SIZE	PUT IN	PULLED OUT
				8-5/8"	323'	None
				5-1/2"	3367'	2694'

Describe in detail the manner in which the well was plugged, indicating where the mud fluid was placed and the method or methods used in introducing it into the hole. If cement or other plugs were used, state the character of same and depth placed, from \_\_\_\_\_ feet to \_\_\_\_\_ feet for each plug set.

Checked hole to 3377', ran 20 gal. of sand to 3360' and dumped 5 sacks of cement with dump bailer. Pulled 5 1/2" casing. Checked fluid to 325', set 15' rock bridge to 310' and ran 25 sacks of cement. Mudded to 40', set 10' rock bridge to 30' and ran 10 sacks of cement to base of cellar.

RECEIVED  
 STATE CORPORATION COMMISSION

PLUGGING COMPLETE.

JAN 30 1961 01-30-61

CONSERVATION DIVISION  
 Wichita, Kansas

(If additional description is necessary, use BACK of this sheet)  
 Name of Plugging Contractor KNIGHT CASING PULLING CO.  
 Address CHASE, KANSAS

STATE OF Kansas, COUNTY OF Sedgwick, ss.  
Bill K. Henrichs (employee of owner) or (~~owner or operator~~) of the above-described well, being first duly sworn on oath, says: That I have knowledge of the facts, statements, and matters herein contained and the log of the above-described well as filed and that the same are true and correct. So help me God.

(Signature) Bill K. Henrichs  
Box 1030, Wichita, Kansas  
 (Address)

SUBSCRIBED AND SWORN TO before me this 27th day of January, 19 61

My commission expires August 19, 1963  
Helen L. Martin Notary Public.



DRILLER'S

LOG

Company: The Derby Oil Company  
Farm: Homolka Well No. 1  
Comm: 11-2-52 Comp: 11-13-52

SW SW SE  
Sec. 26, Twp. 16S, Rge. 11W,  
County: Barton,  
Kansas

Total Depth: 3373'  
Contractor: Peel Brothers, Inc.

Elevation:

Casing: 8-5/8" @ 318' cem.  
5-1/2" @ 3367' cem.

Production:

Figures below indicate bottom of formations

Soil and Clay	0'	105
Sand and Shale		318
Shale and Shells		450
Sand, Pyrite and Red Bed		730
Anhydrite		765
Shale		795
Shale and Red Bed		1165
Shale		1490
Shale and Shells		1780
Shale and Lime		1930
Shale and Lime Streaks		2050
Shale and Lime		2210
Shale and Lime Streaks		2340
Shale and Shells		2525
Shale		2660
Lime and Shale		3205
Lime		3248
Lime and Shale		3296
Lime		3373
Total Depth		3373

REGISTERED  
S.W. PEEL BROTHERS, INC.  
DEPT. 2000  
CONSERVATION DIVISION  
Wichita, Kansas

This is to certify that the above information is to the best of my knowledge true and correct.

PEEL BROTHERS, INC.,

BY: Mendell L. Peel

SUBSCRIBED AND SWORN to before me this 14th day of November, 1952.

Bernice L. Swain  
Notary Public - Barton County, Kansas.

My commission expires April 23, 1955.