


STATE OF KANSAS
STATE CORPORATION COMMISSION

WELL PLUGGING RECORD

Give All Information Completely
Make Required Affidavit
Mail or Deliver Report to
Conservation Division
State Corporation Comm.
245 North Water
Wichita, KS 67202

Hodgeman County. Sec. 18 Twp. 22S Rge. 21W EA
Location as "NE/CNW/SW" or footage from lines
C-NE NW/4

Lease Owner Twin Western Resources, Inc.
Lease Name Korf Well No. 1
Office Address 922 Union Center Bldg., Wichita, KS
Character of Well (Completed as Oil, Gas or Dry Hole) 67202
Dry Hole

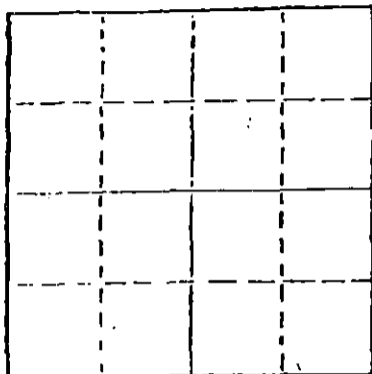

Locate well correctly on above
Section Plat

Date Well completed December 19, 1979
Application for plugging filed Verbal Application 19
Application for plugging approved Verbal Approval 19
Plugging commenced December 19, 1979
Plugging completed December 19, 1979
Reason for abandonment of well or producing formation

If a producing well is abandoned, date of last production
19

Was permission obtained from the Conservation Division or
its agents before plugging was commenced? Yes

Name of Conservation Agent who supervised plugging of this well Clarence Thomas
Producing formation _____ Depth to top _____ Bottom _____ Total Depth of Well 4,461'
Show depth and thickness of all water, oil and gas formations.

OIL, GAS OR WATER RECORDS

CASING RECORD

FORMATION	CONTENT	FROM	TO	SIZE	PUT IN	PULLED OUT
				8-5/8"	385'	None

Describe in detail the manner in which the well was plugged, indicating where the mud fluid
was placed and the method or methods used in introducing it into the hold. If cement or other
plugs were used, state the character of same and depth placed, from _____ feet to
_____ feet for each plug set.

Filled hole with heavy rotary mud from 4,461 ft. (rotary total depth) to
900 ft. Set plug at 900 ft. and cemented with 50 sacks cement. Filled
hole with heavy rotary mud from 900 ft. to 380 ft. Set plug at 380 ft.
and cemented with 35 sacks cement. Filled hole with heavy rotary mud
from 380 ft. to 40 ft. Set solid plug at 40 ft. and cemented to cellar
with 10 sacks cement, 5 sacks cement in rat hole.

Plugging operations accomplished utilizing Allied Oil Well cementing
pump truck through 4 1/2 inch drill pipe.

(If additional description is necessary, use BACK of this report)
Name of Plugging Contractor Allied Cementing Co., Inc.
Box 31, Russell, Kansas 67665 RECEIVED
STATE CORPORATION COMMISSION
JAN - 2 1980

STATE OF Kansas COUNTY OF Sedgwick CONSERVATION DIVISION
Dean Britting, Agent 1-2-83

of the above-described well, being first duly sworn on oath, says: That I have knowledge of
the facts, statements, and matters herein contained and the log of the above-described well
as filed and that the same are true and correct. So help me God.

(Signature) Dean Britting
200 N. Main, Wichita, Kansas 67202
(Address)

SUBSCRIBED AND SWORN TO before me this 28th day of December, 1979

Elsie Willison
Elsie Willison - Notary Public.

My commission expires July 25, 1982

KANSAS DRILLERS LOG

COMPANY Twin Western Resources, Inc.

SEC. 18 T. 22S R. 21W

FARM Korf

NO. 1

LOC. C-NE NW/4

COUNTY Hodgeman

ROTARY TOTAL DEPTH 4,461'

COMM. December 11, 1979 COMP. December 19, 1979

CONTRACTOR H-30, Inc. (Rig #2)

ISSUED December 28, 1979

CASING

10 3/4"

8 5/8" Set at 385' cemented w/225 sxs cement

5 1/2"

4 1/2"

ELEVATION 2,160' K.E.

FIGURES INDICATE BOTTOM OF FORMATIONS

Shale	390'
Shale and Sand	1,020'
Shale and Shells	1,291'
Shale	1,315'
Anhydrite	1,345'
Shale	1,610'
Shale and Lime	2,140'
Shale	2,290'
Shale and Lime	2,495'
Lime and Shale	2,685'
Shale and Lime	2,905'
Shale	3,090'
Lime and Shale	4,020'
Lime	4,461'
Rotary Total Depth	4,461'

I hereby certify the above and foregoing to be a true and correct log of the above described well as shown by the drilling reports.


H-30, INC.

Dean Britting
Dean Britting

State of Kansas }
County of Sedgwick } ss:

Subscribed and Sworn to before me a Notary Public in and for said county and state this 28th day of

December, 1979.

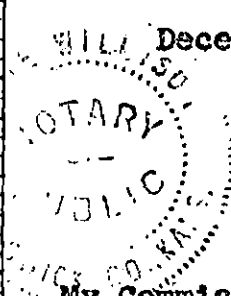

Elsie Willison
Elsie Willison - Notary Public

My Commission Expires:

July 25, 1982

RECEIVED
STATE CORPORATION COMMISSION

JAN - 2 1980

CONSERVATION DIVISION
Wichita, Kansas