

CARD MUST BE TYPED

State of Kansas
NOTICE OF INTENTION TO DRILL

CARD MUST BE SIGNED

(see rules on reverse side)

Starting Date: November 7, 1984
month day year 11 00

OPERATOR: License # 6039
Name L. D. Drilling, Inc.
Address Route 1, Box 183-B
City/State/Zip Great Bend, KS 67530
Contact Person L. D. Davis
Phone 316-793-3051

CONTRACTOR: License # 6039
Name L. D. Drilling, Inc.
City/State Great Bend, KS 67530

Well Drilled For: Well Class: Type Equipment:
 Oil Swd Infield Mud Rotary
 Gas Inj Pool Ext. Air Rotary
 OWWO Expl Wildcat Cable

If OWWO: old well info as follows:

Operator
Well Name
Comp Date Old Total Depth
Projected Total Depth 3310 feet
Projected Formation at TD Arbuckle
Expected Producing Formations LKC - Arbuckle

API Number 15- 009-23, 781 0000
120' East
W/2 E/2 NW Sec 18 Twp 16 S, Rge 11 East
(location) West

3960 Ft North from Southeast Corner of Section
3510 Ft West from Southeast Corner of Section
(Note: Locate well on Section Plat on reverse side)

Nearest lease or unit boundary line 870 feet.
County Barton
Lease Name KRIER A Well# 2
Domestic well within 330 feet: yes no
Municipal well within one mile: yes no

Depth to Bottom of fresh water 175' feet
Lowest usable water formation Dakota
Depth to Bottom of usable water 300 340 m HC feet
Surface pipe by Alternate: 1 2
Surface pipe to be set 340 feet
Conductor pipe if any required NONE feet
Ground surface elevation 1867 (estimate) feet MSL
This Authorization Expires 5-5-85
Approved By 11-5-84

I certify that we will comply with K.S.A. 55-101, et seq., plus eventually plugging hole to K.C.C. specifications.

Date 11-2-84 Signature of Operator or Agent


J. M. Vess

Title
m HC / KOHE 11/5/84
Form C-1 4/84

Must be filed with the K.C.C. five (5) days prior to commencing well
This card void if drilling not started within six (6) months of date received by K.C.C.

RCWD
11-05-84

A Regular Section of Land
1 Mile = 5,280 Ft.

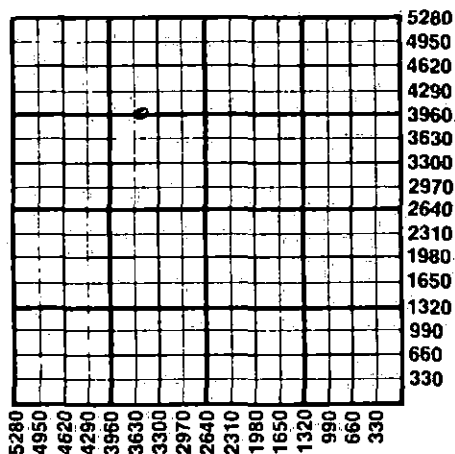

Important procedures to follow:

1. Notify District office before setting surface casing.
2. Set surface casing by circulating cement to the top.
3. File completion forms ACO-1 with K.C.C. within 90 days of well completion, following instructions on ACO-1, side 1, and including copies of wireline logs.
4. Notify District office 48 hours prior to old well workover or re-entry.
5. Prior to plugging, prepare a plugging plan, then obtain agreement from the appropriate district office for an approved plugging plan.
6. Submit plugging report (CP-4) to K.C.C. after plugging is completed.
7. Obtain an approved injection docket number before disposing of salt water.
8. Notify K.C.C. within 10 days when injection commences or terminates.
9. If an alternate 2 completion, cement in the production pipe from below any usable water to surface within 120 days of spud date.

State Corporation Commission of Kansas
Conservation Division
200 Colorado Derby Building
Wichita, Kansas 67202
(316) 263-3238