


WELL PLUGGING RECORD

Give All Information Completely
Make Required Affidavit
Mail or Deliver Report to:
Conservation Division
State Corporation Commission
800 Bittling Building
Wichita, Kansas

NORTH

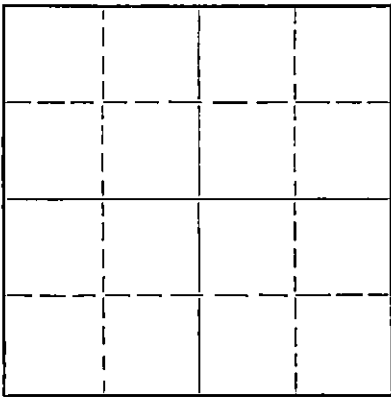

Locate well correctly on above
Section Plat

Kingman County. Sec. 15 Twp. 30S Rge. 10 (E) W (W)
Location as "NE/CNW $\frac{1}{4}$ SW $\frac{1}{4}$ " or footage from lines NE NE SW
Lease Owner Aurora Gasoline Company
Lease Name Campbell Heirs Well No. 1
Office Address 111 Wright Building Annex, Tulsa, Oklahoma
Character of Well (completed as Oil, Gas or Dry Hole) dry
Date well completed 11-6- 1954
Application for plugging filed 11-6- 1954
Application for plugging approved 11-6- 1954
Plugging commenced 11-6- 1954
Plugging completed 11-6- 1954
Reason for abandonment of well or producing formation dry hole

If a producing well is abandoned, date of last production 19
Was permission obtained from the Conservation Division or its agents before plugging was commenced? yes

Name of Conservation Agent who supervised plugging of this well Warren H. Horner
Producing formation Depth to top Bottom Total Depth of Well 4840 Feet
Show depth and thickness of all water, oil and gas formations.

OIL, GAS OR WATER RECORDS

CASING RECORD

Formation	Content	From	To	Size	Put In	Pulled Out
				8-5/8"	212'	

Describe in detail the manner in which the well was plugged, indicating where the mud fluid was placed and the method or methods used in introducing it into the hole. If cement or other plugs were used, state the character of same and depth placed, from feet to feet for each plug set.

Filled hole with mud to 210'. #1 plug set at 210'. Put 1/3 sack of hulls ahead of plug and 15 sacks of cement on top of plug.
Filled hole with mud to 35'. #2 plug set at 35'. Put 1/3 sack of hulls ahead of plug and filled hole with cement from 35' to bottom of cellar.

11-10-54

STATE OF
COUNTY OF


(If additional description is necessary, use BACK of this sheet)
Name of Plugging Contractor Barbour Drilling Company
Address 717 First National Building, Tulsa, Oklahoma

STATE OF Oklahoma, COUNTY OF Tulsa, ss.
E. W. Pribyl (employee of owner) or (owner or operator) of the above-described well, being first duly sworn on oath, says: That I have knowledge of the facts, statements, and matters herein contained and the log of the above-described well as filed and that the same are true and correct. So help me God. BARBOUR DRILLING COMPANY

(Signature) E. W. Pribyl
717 First National Building, Tulsa, Okla.
(Address)

SUBSCRIBED AND SWORN to before me this 6th day of November, 1954.
Merry Jane Burt
Notary Public.

My commission expires July 27, 1957

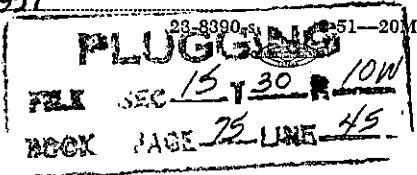

CASEY WELL DRILLING NO. 1

NE 1/4 SW Section 15-30S-10W
Kingman County, Kansas
Aurora Gasoline Company

8-5/8" C. D. casing cemented at 212'

Drilling commenced October 15, 1954
Drilling completed November 6, 1954

FROM	TO	FORMATION	REMARKS
0'	170'	Soil & sand	
170	350	Red bed	8-5/8" C. D. casing cemented with 250 bags cement at 212'
350	1100	Shale & shells	
1100	1185	Lime & shale	
1185	1330	Shale, shells & salt	
1330	1575	Shale & lime streaks	
1575	1650	Lime & shale	
1650	1760	Lime & shale streaks & anhydrite	
1760	1870	Lime	
1870	2000	Lime & shale	
2000	2110	Lime	
2110	2270	Lime & shale	
2270	2460	Shale & lime streaks	
2460	2575	Shale & lime	
2575	2735	Lime & shale	
2735	2875	Shale	
2875	3005	Shale & lime	
3005	3075	Lime & shale	
3075	3115	Lime	
3115	3155	Lime & shale	
3155	3195	Shale	
3195	3280	Shale & lime	
3280	3350	Lime	
3350	3385	Lime & shale	
3385	3465	Shale & lime	
3465	3560	Lime	
3560	3611	Lime & shale	
3611	3735	Sand	
3735	3790	Sand & lime	
3790	4142	Lime	
4142	4185	Lime & shale streaks	
4185	4260	Lime	
4260	4320	Lime & shale	
4320	4410	Lime	
4410	4426	Chert	
4426	4441	Chert & lime	

PLUGGING
 FILE SEC 15 T 30 R 10 W
 BOOK PAGE 25 LINE 45

FROM	TO	FORMATION	REMARKS
4461	4625	Shale	
4625	4637	lime	
4637	4665	lime & sand	
4665	4689	lime	
4689	4701	lime & sand	
4701	4710	Shale	
4710	4739	Hard sand (broken) & shale	
4739	4750	Sand	
4750	4788	Shale	
4788	4817	Shale, lime & sand streaks	
4817	4840	Artuckle lime	Dry hole

T.D. 4840'

This is a true copy of the driller's log as shown on the drilling tickets.

BARDOUR DRILLING COMPANY

By: C. W. Pribil

Subscribed and sworn to before me on this 9th day of November, 1954.

Mary Jane Burt
Notary Public

My commission expires: July 27, 1957