

STATE OF KANSAS
STATE CORPORATION COMMISSION


Form CP-4

Give All Information Completely
Make Required Affidavit
Mail or Deliver Report to:
Conservation Division
State Corporation Commission
212 No. Market
Wichita, Kansas

WELL PLUGGING RECORD

Stafford County. Sec. 15 Twp. 22 Rge. (E) 11 (W)
Location as "NE/CNW $\frac{1}{4}$ /SW $\frac{1}{4}$ " or footage from lines NW SW SW
Lease Owner Aspen Drilling Co.
Lease Name Shepherd Well No. 1
Office Address P. O. Box 783, Great Bend, Kansas
Character of Well (completed as Oil, Gas or Dry Hole) D & A
Date well completed July 28 19 67
Application for plugging filed August 8 19 67
Application for plugging approved _____ 19 _____
Plugging commenced July 28 19 67
Plugging completed Same 19 _____
Reason for abandonment of well or producing formation dry hole

NORTH

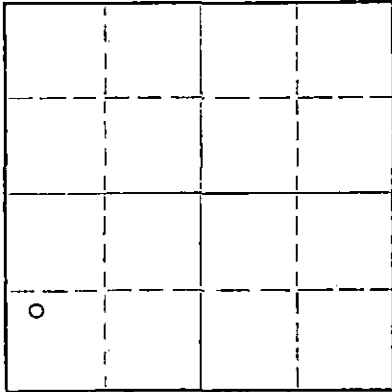

Locate well correctly on above
Section Plat

If a producing well is abandoned, date of last production _____ 19 _____
Was permission obtained from the Conservation Division or its agents before plugging was commenced? yes

Name of Conservation Agent who supervised plugging of this well _____
Producing formation _____ Depth to top _____ Bottom _____ Total Depth of Well 3589 Feet
Show depth and thickness of all water, oil and gas formations.

OIL, GAS OR WATER RECORDS

CASING RECORD

FORMATION	CONTENT	FROM	TO	SIZE	PUT IN	PULLED OUT
Mud to 250'	$\frac{1}{2}$ sack hulls, wood plug &		25	sacks cement.		
Mud to 40'	$\frac{1}{2}$ sack hulls wood plug &		10	sacks cement.		

Describe in detail the manner in which the well was plugged, indicating where the mud fluid was placed and the method or methods used in introducing it into the hole. If cement or other plugs were used, state the character of same and depth placed, from _____ feet to _____ feet for each plug set.

RECEIVED
STATE CORPORATION COMMISSION
AUG 9 1967
CONSERVATION DIVISION
Wichita, Kansas

8-9-67

(If additional description is necessary, use BACK of this sheet)

Name of Plugging Contractor Company tools
Address _____

STATE OF Kansas COUNTY OF Barton, ss.
William S. Schachle (employee of owner) or (owner or operator) of the above-described well, being first duly sworn on oath, says: That I have knowledge of the facts, statements, and matters herein contained and the log of the above-described well as filed and that the same are true and correct. So help me God.

(Signature) William S. Schachle

P. O. Box 783, Great Bend, Kansas
(Address)

SUBSCRIBED AND SWORN to before me this 8th day of August, 19 67

April 18, 1968

Theora Holleman
Notary Public.

