

DEC - 3

12-9-81


STATE OF KANSAS STATE CORPORATION COMMISSION

WELL PLUGGING RECORD

Give All Information Completely Make Required Affidavit Mail or Deliver Report to Conservation Division State Corporation Comm. 245 North Water Wichita, KS 67202

Hodgeman County, Sec. 2 Twp. 22S Rge. 24W E/W Location as "NE/CNW 1/4 SW 1/4" or footage from lines C SE 1/4 SE 1/4

Lease Owner Rine Exploration Company Lease Name Crebbs Well No. 1-2 Office Address 300 W. Douglas, Suite 645, Wichita, Ks. Character of Well (Completed as Oil, Gas or Dry Hole) Dry Hole

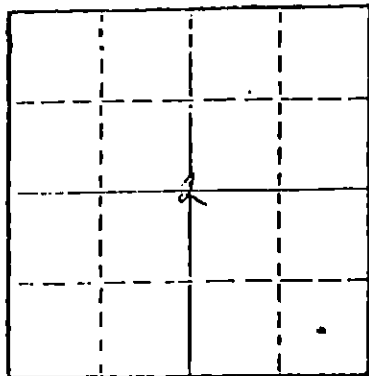

Locate well correctly on above Section Plat

Date Well completed 8/9 19 81 Application for plugging filed 8/9 19 81 Application for plugging approved 8/9 19 81 Plugging commenced 8/9 19 81 Plugging completed 8/9 19 81 Reason for abandonment of well or producing formation Dry Hole

If a producing well is abandoned, date of last production 19

Was permission obtained from the Conservation Division or its agents before plugging was commenced? yes

Name of Conservation Agent who supervised plugging of this well Metz, Stafford, Ks. Producing formation Depth to top Bottom Total Depth of Well Show depth and thickness of all water, oil and gas formations.

OIL, GAS OR WATER RECORDS

CASING RECORD

Table with 7 columns: FORMATION, CONTENT, FROM, TO, SIZE, PUT IN, PULLED OUT

Describe in detail the manner in which the well was plugged, indicating where the mud fluid was placed and the method or methods used in introducing it into the hold. If cement or other plugs were used, state the character of same and depth placed, from feet to feet for each plug set.

Hole plugged with 60-40 Pozmix 4% Gel, 3% CC.

Bottom plug @ 900' w/ 60 sks

2nd plug @ 600' w/ 40 sks

Top plug @ 40' w/ 10 sks

w/Hulls @ plug

10 sks in the Rate hole

5 sks in the mouse hole

Complete at 3:15 P.S. 8/9/81

(If additional description is necessary, use BACK of this sheet)

Name of Plugging Contractor

STATE OF Kansas COUNTY OF Sedgwick, ss. Jerome D. Marcus (employee of owner) or (owner or operator)

of the above-described well, being first duly sworn on oath, says: That I have knowledge of the facts, statements, and matters herein contained and the log of the above-described well as filed and that the same are true and correct. So help me God.

(Signature) [Signature]

(Address)

SUBSCRIBED AND SWORN TO before me this 18th day of August, 19 81

[Signature] Cheryl L. Benoit Notary Public.

My commission expires June 8, 1985

