


STATE OF KANSAS
STATE CORPORATION COMMISSION

WELL PLUGGING RECORD

Give All Information Completely
Make Required Affidavit
Mail or Deliver Report to:
Conservation Division
State Corporation Commission
211 No. Broadway
Wichita, Kansas

Rice County. Sec. 3 Twp. 22 Rge. 8 (W)
Location as "NE/CNW/SW" or footage from lines C N/2 SW
Lease Owner Thos. H. Allan, et al
Lease Name Mayer Unit Well No. 5
Office Address 925 Union Center, Wichita 2, Kansas
Character of Well (completed as Oil, Gas or Dry Hole) Oil & Gas
Date well completed February 6 19 54
Application for plugging filed November 4 19 57
Application for plugging approved November 6 19 57
Plugging commenced November 12 19 57
Plugging completed November 15 19 57
Reason for abandonment of well or producing formation Exhausted

NORTH

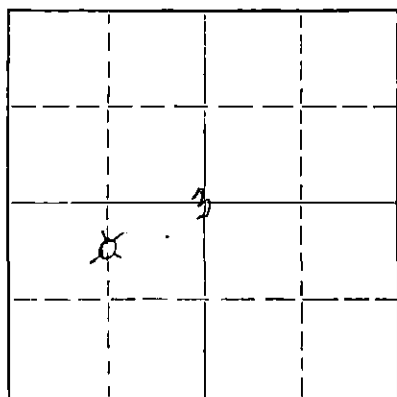

Locate well correctly on above
Section Plat

If a producing well is abandoned, date of last production July 19 57
Was permission obtained from the Conservation Division or its agents before plugging was commenced? Yes

Name of Conservation Agent who supervised plugging of this well Robert P. Bockert Ruel Durkee
Producing formation Mississippian Depth to top 3344 Bottom ----- Total Depth of Well 3357 Feet
Show depth and thickness of all water, oil and gas formations.

OIL, GAS OR WATER RECORDS

CASING RECORD

FORMATION	CONTENT	FROM	TO	SIZE	PUT IN	PULLED OUT
				8 5/8"	200'	None
				5 1/2"	3347'	2805'

Describe in detail the manner in which the well was plugged, indicating where the mud fluid was placed and the method or methods used in introducing it into the hole. If cement or other plugs were used, state the character of same and depth placed, from _____ feet to _____ feet for each plug set.

3357 - 3335 Gravel
 3335 - 3295 6 sacks of cement
 @ 2800 Shot Casing - recovered 2805 feet
 3295 - 190 Mud
 190 - 145 Rock Bridge and 15 sacks cement
 145 - 20 Mud
 20 - Surface Rock Bridge and 5 sacks cement

11-21-57

NOV 21 1957
WICHITA, KANSAS

(If additional description is necessary, use BACK of this sheet)

Name of Plugging Contractor Miller Casing Pulling Company
Address Great Bend, Kansas

STATE OF KANSAS, COUNTY OF SEDGWICK, ss.
Thos. H. Allan (employer/owner) or (owner or operator) of the above-described

well, being first duly sworn on oath, says: That I have knowledge of the facts, statements, and matters herein contained and the log of the above-described well as filed and that the same are true and correct. So help me God.

(Signature) Thos. H. Allan

925 Union Center, Wichita 2, Kansas
(Address)

SUBSCRIBED AND SWORN TO before me this 20th day of November, 19 57

Oris M. Stewart
Notary Public.

My commission expires June 14, 1958

PLUGGING
NOV 10 3 12 PM '57
BOOK PAGE 59 LINE 16

15-159.05534-0000

11/5/57

PLEASE NOTE:

WELL PLUGGING APPLICATION FORM FOR #5 MAYER UNIT was mailed to you today, and this *well log* should have been attached to the application.

STATE OF KANSAS
COMMISSIONER OF REVENUE

THOS. H. ALLAN
925 Union Center
Wichita 2, Kansas

15-159-05534-0000

8.5/8" @ 200' - 140 sx
5 1/2" @ 3347' - 75 sx

ALLAN, ET AL #1 MAYER "B" (#5 Mayer Unit)
O N/2 SW 3-22-3W
Rice County, Kansas
COMM: 1/18/54 COMPL: 2/6/54
CONTRACTOR: Tom Allan
ELEVATION: 1630 RB

I.P. Flow 30 BOPD

All Depths from Rotary Bushings

0 - 85 Sand
 115 Yellow Clay & Sand
 380 Red Beds
 680 Shale
 1180 Salt & Shale
 1330 Shale & Anhydrite
 1340 Red Shale
 2460 Lime & Shale
 2500 Sand
 2865 Lime & Shale
 2938 Shale & Sand
 2947 Brown Lime
 2963 Shale
 3068 Lime with Shale Breaks
 3080 Soft Oolitic Lime
 3193 Lime with Shale Breaks
 3197 Soft Oolitic Lime
 3218 Lime
 3344 Lime & Shale
 3347(RTD) White Vitreous Chert &
 Tripoli with Light Stain
 3347RB - 3347 RB Cable Tools
 3357 (TD) White Weathered Chert &
 Tripoli with slight show gas

FORMATION TOPS:

Brown Lime	2938 RB
Lansing	2963 RB
Mississippian	3344 RB

TESTING:

Drilled shoe and drilled deeper to 3357' -
Slight show of gas, no oil.
Fracture with 300 bbl. water & 4800# sand.
Flow 30 BOPD

RECEIVED
7/27/54
CORRECTION

PLUGGING	
FILE	SEC. 3 T. 22 R. 8W
BOOK	PAGE 59 LINE 16