

WMP
12


STATE OF KANSAS
STATE CORPORATION COMMISSION

Form CP-4

Give All Information Completely
Make Required Affidavit
Mail or Deliver Report to:
Conservation Division
State Corporation Commission
211 No. Broadway
Wichita, Kansas

WELL PLUGGING RECORD

NORTH

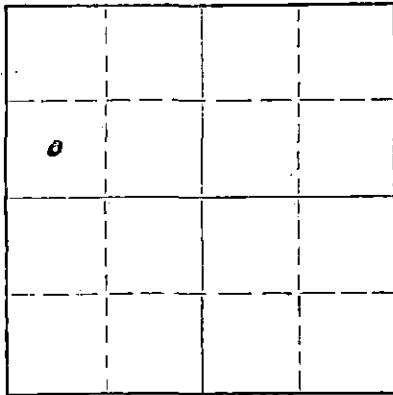

Locate well correctly on above
Section Plat

Rice County. Sec. 2 Twp. 22 Rge. 8 (E) W (W)
Location as "NE/CNW%SW%" or footage from lines App. C SW - NW
Lease Owner Chief Drilling Company Box 797 Great Bend, Kansas
Lease Name Harper Well No. 1
Office Address Box 797 Great Bend, Kansas
Character of Well (completed as Oil, Gas or Dry Hole) Dry Hole
Date well completed 11-22 19 65
Application for plugging filed 11-22 19 65
Application for plugging approved 11-22 19 65
Plugging commenced 11-22 19 65
Plugging completed 11-22 19 65
Reason for abandonment of well or producing formation Dry Hole

If a producing well is abandoned, date of last production 19
Was permission obtained from the Conservation Division or its agents before plugging was commenced? YES

Name of Conservation Agent who supervised plugging of this well Gilbert J. Toman Holyrood, Kansas
Producing formation Depth to top Bottom Total Depth of Well 3430 Feet
Show depth and thickness of all water, oil and gas formations.

OIL, GAS OR WATER RECORDS

CASING RECORD

FORMATION	CONTENT	FROM	TO	SIZE	PUT IN	PULLED OUT

Describe in detail the manner in which the well was plugged, indicating where the mud fluid was placed and the method or methods used in introducing it into the hole. If cement or other plugs were used, state the character of same and depth placed, from 3430 feet to 190 feet for each plug set.
Mud from total depth to 190 feet - with 25 sks of cement. Top plugs set @ 40 feet - with 10 sks of cement. Two sks. cement in rathole.

RECEIVED
STATE CORPORATION COMMISSION

NOV 30 1965

CONSERVATION DIVISION
WICHITA, KANSAS

(If additional description is necessary, use BACK of this sheet)

Name of Plugging Contractor German Drilling Company
Address 502 Petroleum Building Wichita, Kansas 67202

STATE OF Kansas, COUNTY OF Sedgwick, ss.
German Drilling Company (employee of owner) or (owner or operator) of the above-described well, being first duly sworn on oath, says: That I have knowledge of the facts, statements, and matters herein contained and the log of the above-described well as filed and that the same are true and correct. So help me God.

(Signature) Harvey E. Toman
502 Petroleum Building Wichita, Kansas 67202
(Address)

SUBSCRIBED AND SWORN to before me this twenty-second day of November, 1965

Geneva M. German
Geneva M. German - Notary Public.

My commission expires February 28, 1968

WELL LOG - Harper # 1

OPERATOR: Chief Drilling Company
Box 797
Great Bend, Kansas

LOCATION: App. C SW - NW
Sec. 2-22-8W
Rice County, Kansas

CONTRACTOR: German Drilling Company
502 Petroleum Building
Wichita, Kansas 67202

Farm: Harper
Date Commenced: 11-12-65
Date Completed: 11-23-65

Well No. 1

From	To	Formation
0	35	Sand
35	50	River Gravel
50	130	Shale-Sand
130	160	Red Bud-Shale
160	196	Shale
196	204	Shale
204	230	Red Bed
230	1045	Shale
1045	1080	Shale
1080	1130	Anhydrite
1130	1390	Shale-Shells
1530	1666	Shale-Lime Streaks
1666	2015	Shale-Lime
2015	2235	Shale-Lime
2235	2540	Shale-Lime
2540	2674	Shale-Lime
2674	2819	Lime-Shale
2819	2959	Lime-Shale
2959	3044	Shale-Lime
3044	3117	Lime-Shale
3117	3179	K.C. Lime Stone
3179	3228	Lime-Shale
3228	3290	Lime W/Shale
3290	3355	Lime
3355	3405	Lime-Shale
3405	3430	Mississippi
3430	T.D.	

I hereby certify that the foregoing is a true and correct copy of the Well log for the Harper # 1, drilled for Chief Drilling Company and completed November 23, 1965.

GERMAN DRILLING COMPANY

RECEIVED

HARVEY F. GERMAN - Owner

STATE OF KANSAS

COUNTY OF SEDGWICK

ss.

NOV 30 1965

CONSTRUCTION DIVISION

Subscribed and sworn to, before the undersigned, a Notary Public, in and for County and State aforesaid, this twenty-ninth day of November, 1965.

Geneva M. German
Geneva M. German - Notary Public

My Commission expires February 28, 1968