

STATE OF KANSAS  
STATE CORPORATION COMMISSION

Give All Information Completely  
Make Required Affidavit  
Mail or Deliver Report to:  
Conservation Division  
State Corporation Commission  
212 No. Market  
Wichita, Kansas

WELL PLUGGING RECORD

Stafford County, Sec. 7 Twp. 22S Rge. 11W (E) (W)

Location as "NE/CNW/SW" or footage from lines NW SW NE

Lease Owner Ben C. W. Hyde, Jr.

Lease Name Hammeke Well No. 1

Office Address 4000 Somerset Drive, Prairie Village, Ks. 66208

Character of Well (completed as Oil, Gas or Dry Hole) Dry Hole

Date well completed March 3 1969

Application for plugging filed March 3 1969

Application for plugging approved March 3 1969


Plugging commenced March 3 1969

Plugging completed March 3 1969

Reason for abandonment of well or producing formation Dry Hole

If a producing well is abandoned, date of last production 19

Was permission obtained from the Conservation Division or its agents before plugging was commenced? yes

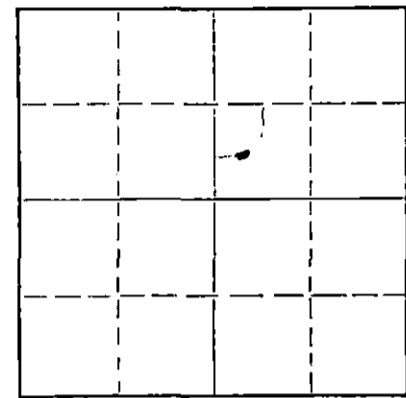

Locate well correctly on above Section Plat

Name of Conservation Agent who supervised plugging of this well Ralph Warren

Producing formation \_\_\_\_\_ Depth to top \_\_\_\_\_ Bottom \_\_\_\_\_ Total Depth of Well 3695 Feet

Show depth and thickness of all water, oil and gas formations.

OIL, GAS OR WATER RECORDS

CASING RECORD

FORMATION	CONTENT	FROM	TO	SIZE	PUT IN	PULLED OUT
Red Rock		110	252	8 5/8"	249	NONE

Describe in detail the manner in which the well was plugged, indicating where the mud fluid was placed and the method or methods used in introducing it into the hole. If cement or other plugs were used, state the character of same and depth placed, from \_\_\_\_\_ feet to \_\_\_\_\_ feet for each plug set.

Filled hole with mud to 500', 50 sacks cement.

Filled hole with mud to 240', 25 sacks cement.

Filled hole with mud to 40', plug, 1/2 sack hulls, 10 sacks cement.

Job completed 5:00 a.m. 3-3-69.

RECEIVED  
STATE CORPORATION COMMISSION  
MAR 4 1969  
CONSERVATION DIVISION  
Wichita, Kansas

(If additional description is necessary, use BACK of this sheet)

Name of Plugging Contractor ISERN DRILLING COMPANY

Address Box 486, Ellinwood, Kansas 67526

STATE OF KANSAS, COUNTY OF BARTON, ss. W. F. Banks

(employee of owner) or (owner or operator) of the above-described well, being first duly sworn on oath, says: That I have knowledge of the facts, statements, and matters herein contained and the log of the above-described well as filed and that the same are true and correct. So help me God.

(Signature) W. F. Banks

Box 486, Ellinwood, Kansas 67526  
(Address)

SUBSCRIBED AND SWORN to before me this 3rd day of March, 1969

My commission expires February 10, 1971.

George A. Meyer  
Notary Public.

W E L L L O G

RECEIVED  
STATE CORPORATION COMMISSION  
MAR 4 1969  
CONSERVATION DIVISION  
Wichita, Kansas

Ben C. W. Hyde, Jr. HAMMEKE #1  
NW SW NE, Section 7-22S-11W  
Stafford County, Kansas

ELEVATION: 1790' GL; 1792' DF; 1794' KB.

Figures indicate bottom of formation:

C  
O  
P  
Y

PIPE RECORD:  
8 5/8" set @ 249'  
with 250 sacks cement.

DRY & ABANDONED

ROTARY COMMENCED: 2-21-69  
ROTARY COMPLETED: 3-3 -69


TOPS

Anhydrite 534  
Heebner 3070  
Brown Lime 3203  
Lansing 3230  
Conglomerate 3484  
Viola 3500  
Simpson Sand 3568  
Arbuckle 3599

0 to 60 sand  
110 shale  
546 red bed  
1445 shale & shells  
2175 lime & shale  
2775 shale & shells  
3000 lime & shale  
3190 shale & lime streaks  
3505 lime & shale  
3535 lime & chert  
3553 chert & sand with shale  
3575 shale  
3602 shale & lime  
3695 lime & shale  
3695 Rotary Total Depth


STATE OF KANSAS )  
COUNTY OF BARTON ) ss

I, W. F. Banks, Drilling Superintendent of Isern Drilling Company, contractor for the above-described well, being first duly sworn on oath, declare: That I have knowledge of the facts, statements and matter herein contained pertaining to the log of the above-described well, as filed, and that the same are true and correct.

  
\_\_\_\_\_  
W. F. Banks

Subscribed and sworn to before me on this 3rd day of March, 1969.

My commission Expires: 2-10-71.

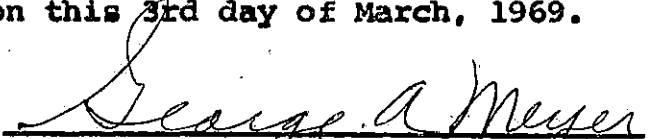  
\_\_\_\_\_  
George A. Meyer, Notary Public