


WELL PLUGGING RECORD

Give All Information Completely
Make Required Affidavit
Mail or Deliver Report to:
Conservation Division
State Corporation Commission
211 No. Broadway
Wichita, Kansas

NORTH

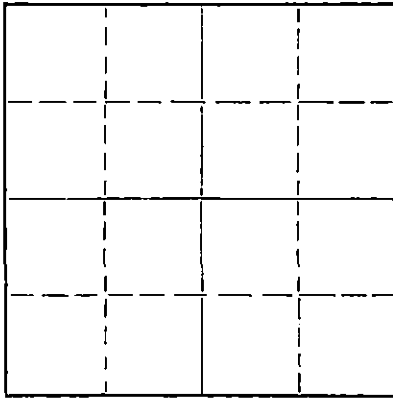

Locate well correctly on above
Section Plat

Stafford County. Sec. 7 Twp. 22 Rge. 11 (E) W (W)
Location as "NE/CNW/SW" or footage from lines SW/4 SW/4 SW/4
Lease Owner Stearns Petroleum Co.
Lease Name Stearns Petroleum Co - Wolfe Well No. 1
Office Address Russell, Kansas
Character of Well (completed as Oil, Gas or Dry Hole) _____
Date well completed _____ 19____
Application for plugging filed _____ 19____
Application for plugging approved _____ 19____
Plugging commenced Jan 21 19 57
Plugging completed Feb 5 19 57
Reason for abandonment of well or producing formation _____

If a producing well is abandoned, date of last production _____ 19____
Was permission obtained from the Conservation Division or its agents before plugging was commenced? yes

Name of Conservation Agent who supervised plugging of this well Russell Brundage
Producing formation _____ Depth to top _____ Bottom _____ Total Depth of Well 3621 Feet
Show depth and thickness of all water, oil and gas formations.

OIL, GAS OR WATER RECORDS

CASING RECORD

FORMATION	CONTENT	FROM	TO	SIZE	PUT IN	PULLED OUT

Describe in detail the manner in which the well was plugged, indicating where the mud fluid was placed and the method or methods used in introducing it into the hole. If cement or other plugs were used, state the character of same and depth placed, from 3621 feet to Surface feet for each plug set.
Hole filled with sand from 3621 to 3595; Five sacks of cement placed in hole with dump bailer, pulled pipe and had Halliburton pump trucks pump in 25 sacks of starch mud, followed by a plug, pumped down with 65 sacks of cement.
Plugging Complete.

(If additional description is necessary, use BACK of this sheet)

Name of Plugging Contractor Barnes and Sons Pipe Pulling Co.
Address Russell, Kansas

STATE OF Kansas, COUNTY OF Russell, ss.
D. L. Comstock (employee of owner) or (owner or operator) of the above-described well, being first duly sworn on oath, says: That I have knowledge of the facts, statements, and matters herein contained and the log of the above-described well as filed and that the same are true and correct. So help me God.

(Signature) D. L. Comstock
Box 213, Russell, Kansas
(Address)

SUBSCRIBED AND SWORN TO before me this 11th day of February, 191957

My commission expires April 5, 1958
Betty Lou Miller Notary Public.

PLUGGING
FILE SEC 7 T. 22 R. 11W
BOOK PAGE 125 LINE 32

FEB 12 1957 2-12-57
CONSERVATION DIVISION
Wichita, Kansas

WOLF #1

Operator: Stearns Petroleum, Inc.
 Contractor: Stearns Petroleum, Inc.
 Commencement Date: September 13, 1955
 Completion Date: September 25, 1955

Location:
 SW SW SW
 Section 7, 22South 11West,
 Stafford County, Kansas

Casing Record:

Ran 10 joints used 8-5/8" 8 R. Casing, cemented with 120 sacks Pozmix, one sack Calcium Chloride. Pipe set at 200 feet. Also ran 113 joints 8 R. 5-1/2" O. D. Casing. Pipe set at 3609 feet. Cemented with 75 sacks Pozmix.

WELL LOG

Sand & Clay	0	100
Red Bed	100	200
Red Bed & Shale	200	580
Anhydrite	580	598
Shale & Sand	598	850
Shale & Shells	850	1520
Lime & Shale	1520	1741
Lime	1741	1840
Lime & Shale	1840	2090
Lime	2090	2180
Lime & Shale	2180	2954
Sandy Red Shale	2954	2966
Lime	2966	3128
Lime & Shale	3128	3242
Lime	3242	3555
Simpson Shale	3555	3608
Arbuckle	3608	3613
Total Depth	3613	

STATE OF KANSAS)
) SS:
 COUNTY OF RUSSELL)

I hereby certify that the above information is true and correct to the best of my knowledge.

O. G. Stearns
 O. G. Stearns, President

SUBSCRIBED AND SWORN to before me, a Notary Public, this 26th day of September, 1955.

Betty Lou Miller
 Betty Lou Miller, Notary Public

My Commission Expires:

April 5, 1958

PLUGGING
 FILE SEC. 7 T. 22 R. 11W
 BOOK PAGE 125 LINE 32

RECEIVED
 STATE CORPORATION COMMISSION
 FEB 12 1957
 CONSERVATION DIVISION
 Wichita, Kansas