

STATE OF KANSAS
STATE CORPORATION COMMISSION


WELL PLUGGING RECORD

Give All Information Completely
Make Required Affidavit
Mail or Deliver Report to:
Conservation Division
State Corporation Commission
800 Bittling Building
Wichita, Kansas

OR
FORMATION PLUGGING RECORD

Strike out upper line
when reporting plug-
ging of formations.

NORTH

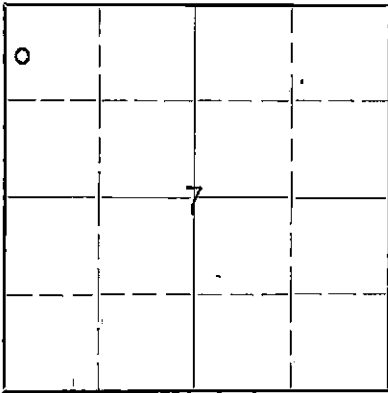

Locate well correctly on above
Section Plat

Stafford County, Sec 7 Twp 22S Rge (E) 11 (W)

Location as "NE1/4NW1/4SW1/4" or footage from lines OWL NW NW1/4
Lease Owner Shell Oil Co., Inc. (Community)
Lease Name F. Wolf Well No. 1
Office Address Box 744, Great Bend, Kansas
Character of Well (completed as Oil, Gas or Dry Hole) Dry Hole
Date well completed December 14 19 43
Application for plugging filed December 20 19 43
Application for plugging approved December 27 19 43
Plugging commenced December 17 19 43
Plugging completed December 17 19 43
Reason for abandonment of well or producing formation Dry Hole

If a producing well is abandoned, date of last production _____ 19____
Was permission obtained from the Conservation Division or its agents before plugging was com-
menced? Yes

Name of Conservation Agent who supervised plugging of this well G. T. Alexander
Producing formation Arbuckle Depth to top 3646 Bottom _____ Total Depth of Well 3676 Feet
Show depth and thickness of all water, oil and gas formations.

OIL, GAS OR WATER RECORDS


CASING RECORD

Formation	Content	From	To	Size	Put In	Pulled Out
Arbuckle	Dry	3646	3676	8 5/8"	315'	None

Describe in detail the manner in which the well was plugged, indicating where the mud fluid was placed and the method of methods used in introducing it into the hold. If cement or other plugs were used, state the character of same and depth placed, from _____ feet to _____ feet for each plug set.

Mudded hole from 3676 to 315; cemented from 315 to 280 with 15 sax; mudded to 26'; & cemented with 10 sax to cellar.

PLUGGING
FILE # 7-229-1160
BOOK PAGE 102 LINE 41

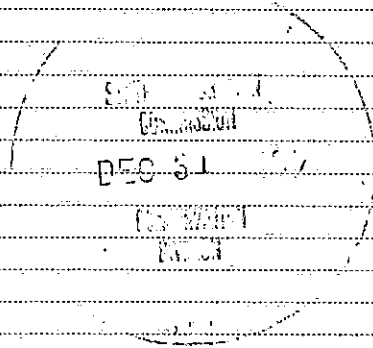

12-31-43

(If additional description is necessary, use BACK of this sheet)

Correspondence regarding this well should be addressed to Shell Oil Co., Inc.
Address c/o W. M. Gholson, Box 744, Great Bend, Kansas

STATE OF Kansas COUNTY OF Barton, ss.
W. M. Gholson (employee of owner) ~~or (owner or operator)~~ of the above-described well,

being first duly sworn on oath, says: That I have knowledge of the facts, statements, and matters herein contained and the log of the above-described well as filed and that the same are true and correct. So help me God.

(Signature) W. M. Gholson

Box 744, Great Bend, Kansas
(Address)

SUBSCRIBED AND SWORN to before me this 30th day of December, 19 43

Betty Pastlethwaite
Notary Public.

My commission expires 1-24-45

Community-Shell, F. Wolf #1
 CWL NW NW 7-22S-11W
 Stafford County, Kansas

Casing Record

8 5/8" cem. 315 with 200 sax &
 2% Aquagel.

0 - 25 sand
 70 sand & shale
 170 red rock
 315 red rock & shells
 465 red bed
 549 shale & shells
 568 anhydrite
 1000 shale & shells
 1315 shale & salt
 1380 shale & shells
 1468 anhydrite, shale streaks
 1559 anhydrite & shale
 1623 lime & chert
 1685 lime
 1795 lime & shale breaks
 1805 cherty lime
 1830 lime & chert
 1875 broken lime & shale
 2762 lime & shale
 2840 lime, chert & shale
 Top Topeka 2776
 3084 lime
 3145 lime & shale
 3343 lime Top Lans. Kans. City 3212
 3374 lime & chert streaks
 3374=3369 SLC
 3468 lime
 Top Sooy Cong. 3468
 3556 conglomerate
 Top Viola 3556
 3565 chert
 3569 conglomerate & chert streaks
 3643 lime & chert
 Top Simpson Fmtn 3590
 3646 dolomite
 3646=3649 SLC
 Top Arbuckle 3646
 3676 dolomite TD

	7	22	11W
EDON	102	41	

DEC 2