

OCT 08 1982

FORM CP-4


STATE OF KANSAS
STATE CORPORATION COMMISSION

WELL PLUGGING RECORD
CONSERVATION DIVISION
Wichita, Kansas

Give All Information Completely
Make Required Affidavit
Mail or Deliver Report to
Conservation Division
State Corporation Comm.
245 North Water
Wichita, KS 67202

Hamilton County, Sec. 25 Twp. 24 Rge. 41 NW
Location as "NE/CNW $\frac{1}{4}$ SW $\frac{1}{4}$ " or footage from lines
1320 FSL & 20' FEL (25-24-41S)

Lease Owner Dome Petroleum Corp.
Lease Name Grabler-Cook Well No. A-1
Office Address Dome Pet, Corp. 2900 Dome Tower 1625 Broadway
Character of Well (Completed as Oil, Gas or Dry Hole) Denver Co
Gas 80202

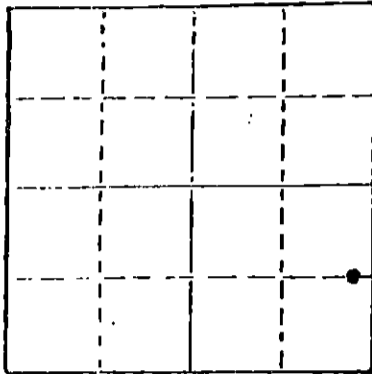

Locate well correctly on above
Section Plat

Date Well completed 19
Application for plugging filed 6-26-82 19
Application for plugging approved 6-28-82 19
Plugging commenced 9-18-82 19
Plugging completed 9-21-82 19
Reason for abandonment of well or producing formation
Non commercial value

If a producing well is abandoned, date of last production
None 19

Was permission obtained from the Conservation Division or
its agents before plugging was commenced? yes

Name of Conservation Agent who supervised plugging of this well Mr. Luthi
Producing formation Hugoton Depth to top 2410' Bottom 2418' Total Depth of Well 2458'
Show depth and thickness of all water, oil and gas formations.

OIL, GAS OR WATER RECORDS

CASING RECORD

FORMATION	CONTENT	FROM	TO	SIZE	PUT IN	PULLED OUT
Surface				8 5/8"	350'	0'
Production				4 1/2"	2458'	1904'

Describe in detail the manner in which the well was plugged, indicating where the mud fluid
was placed and the method or methods used in introducing it into the hold. If cement or other
plugs were used, state the character of same and depth placed, from feet to
feet for each plug set.

Pumped 1 sk. hulls & 15 sks. cement to 2230' - Pressured to 750 lbs.
Pumped 50 sks. cement, 5 sks. Gel & 35 sks. cement 250' to 1300'
Put bridge & 10 sks. cement 40' to 0'
Cut off 8 5/8", 3' below ground level & weld plate on same

(If additional description is necessary, use BACK of this sheet)

Name of Plugging Contractor Midwest Casing Pulling Service
Lic. # 6497

STATE OF KANSAS COUNTY OF Haskell, ss.
I, Edgar J. Eves (employee of owner) or (owner or operator)

of the above-described well, being first duly sworn on oath, says: That I have knowledge of
the facts, statements, and matters herein contained and the log of the above-described well
as filed and that the same are true and correct. So help me God.

(Signature)

Edgar J. Eves

Box F, Sublette, Ks. 67877

(Address)

SUBSCRIBED AND SWORN TO before me this 24th day of Sept, 1982

Sandra J. Eves

Notary Public.

My commission expires 12-6-84

