

WELL PLUGGING RECORD

Information Completely
Required Affidavit
Mail or Deliver Report to:
Conservation Division
State Corporation Commission
212 North Market, Insurance Bldg.
Wichita, Kansas

7 Kingman County. Sec. 36 Twp. 30 Rge. (E) 10 (W)

Location as "NE/CNW/SW" or footage from lines C SW SW

Lease Owner Aylward Drilling Company

Lease Name Pagenkopf Well No. 1

Office Address 813 1st Nat'l Bank Bldg. - Wichita 2, Kansas

Character of Well (completed as Oil, Gas or Dry Hole) Dry Hole

Date well completed July 8, 1961

Application for plugging filed July 7, 1961

Application for plugging approved July 8, 19 61


Plugging commenced July 8, 19 61

Plugging completed July 8, 19 61

Reason for abandonment of well or producing formation _____

If a producing well is abandoned, date of last production _____ 19 _____

Was permission obtained from the Conservation Division or its agents before plugging was commenced? Yes

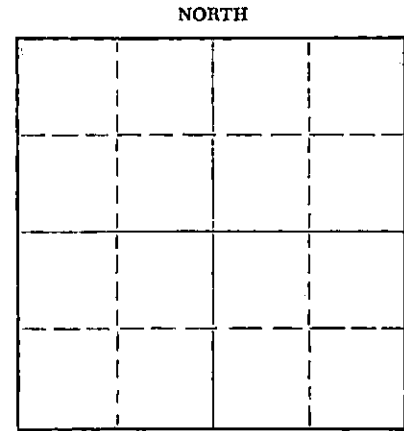

Locate well correctly on above Section Plat

Name of Conservation Agent who supervised plugging of this well Fred W. Hampel

Producing formation _____ Depth to top _____ Bottom _____ Total Depth of Well 4621 Feet

Show depth and thickness of all water, oil and gas formations.

OIL, GAS OR WATER RECORDS

CASING RECORD

FORMATION	CONTENT	FROM	TO	SIZE	PUT IN	PULLED OUT
				8 5/8"	196	None

Describe in detail the manner in which the well was plugged, indicating where the mud fluid was placed and the method or methods used in introducing it into the hole. If cement or other plugs were used, state the character of same and depth placed, from _____ feet to _____ feet for each plug set.

Filled hole with heavy mud to 190'

Cement plug with 27 sacks cement.

Cement plug at 35' with 15 sacks cement

Cement plug at top with 10 sacks.

2 sacks cement in rathole.

RECEIVED
STATE CORPORATION COMMISSION
JUN 27 1962
CONSERVATION DIVISION
Wichita, Kansas

6-27-62

Name of Plugging Contractor Company tools
Address _____

STATE OF Kansas COUNTY OF Sedgwick, ss.
Paul W. Hesse (employee of owner) or (owner or operator) of the above-described

well, being first duly sworn on oath, says: That I have knowledge of the facts, statements, and matters herein contained and the log of the above-described well as filed and that the same are true and correct. So help me God.

(Signature) Paul W. Hesse

813 1st Nat'l Bank Bldg. - Wichita 2, Kansas
(Address)

SUBSCRIBED AND SWORN TO before me this 26th day of July, 1961

Duane Jessup
DUANE JESSUP Notary Public.

My commission expires December 11, 1961

PAGENKOPF NO. 1

Casing Record:
8 5/8" - 196'

Company: Aylward Drilling Company et al
Contractor: Aylward Drilling Company
Commenced: June 22, 1961
Completed: July 8, 1961

Location: C SW SW
Sec. 36-30-10W
Kingman County
Kansas

Elev.: 1721 K.B.

	<u>From</u>	<u>To</u>	<u>Remarks</u>
Sand	0	45	Set 8 5/8" surface pipe @ 196' w/190 sacks cement.
Red Bed	45	150	
Red Bed & Shells	150	180	Geological Tops:
Red Rock - Hard	180	240	
Red Bed, Rock & Sand	240	680	Lansing-K.C. 3760
Red Bed & Shale	680	805	Mississippian 4428
Shale & Shells	805	1405	Kinderhook 4596
Shale	1405	1535	DST 4427-55 Open 1'10"
Shale & Lime	1535	1620	
Lime	1620	1875	Rec. 10' mud
Shale & Lime	1875	2065	IBHP 161#/45" - FBHP 56#/60"
Lime	2065	2190	FP 31#-31#
Lime & Shale	2190	2730	
Shale & Lime	2730	3020	
Lime & Shale	3020	3203	
Shale & Lime	3203	3440	
Lime & Shale	3440	3496	
Shale & Lime	3496	3850	
Lime	3850	3930	
Shale & Lime	3930	3990	
Lime	3990	4070	
Lime & Shale	4070	4160	
Lime	4160	4400	
Lime & Shale	4400	4570	
Lime, Shale & Chert	4570	4580	
Lime	4580	4621 T.D.	D & A

RECEIVED
STATE CORPORATION COMMISSION
JUN 27 1962
CONSERVATION DIVISION
Wichita, Kansas

I hereby certify that this is a true and correct copy of the above log to the best of my knowledge.

Charles D. Williams

Subscribed and sworn to before me this 24th day of July, 1961.

Duane Jessup
DUANE JESSUP Notary Public

My commission expires December 11, 1961.