


STATE OF KANSAS
STATE CORPORATION COMMISSION

WELL PLUGGING RECORD

Give All Information Completely
Make Required Affidavit
Mail or Deliver Report to
Conservation Division
State Corporation Comm.
245 North Water
Wichita, KS 67202

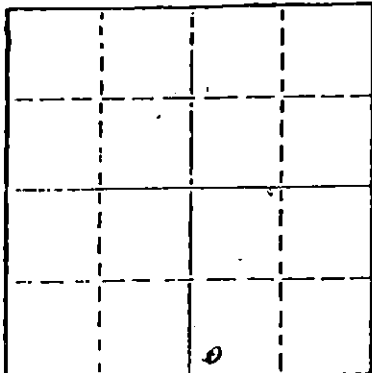

Locate well correctly on above
Section Plot

Barton County. Sec. 29 Twp. 16 Rge. 11W E/W
Location as "NE/CNW $\frac{1}{4}$ SW $\frac{1}{4}$ " or footage from lines
SW SW SE

Lease Owner M. & P. Petroleum Inc.
Lease Name J. J. Dolechek Well No. 3
Office Address Box 746 McPherson Ks. 67460
Character of Well (Completed as Oil, Gas or Dry Hole) _____

Oil

Date Well completed 8/18 19 45
Application for plugging filed 7/ 19 79
Application for plugging approved 7/79 19 79
Plugging commenced 8/7 19 79
Plugging completed 8/7 19 79
Reason for abandonment of well or producing formation _____

Dry

If a producing well is abandoned, date of last production _____ 19 78

Was permission obtained from the Conservation Division or
its agents before plugging was commenced? Yes

Name of Conservation Agent who supervised plugging of this well Duane Rankin
Producing formation Arb. Depth to top 3326 Bottom 3335 Total Depth of Well 3335
Show depth and thickness of all water, oil and gas formations.

OIL, GAS OR WATER RECORDS

CASING RECORD

FORMATION	CONTENT	FROM	TO	SIZE	PUT IN	PULLED OUT
	Surface	0	535	8 5/8		
		0	3326	5 1/2		500

Describe in detail the manner in which the well was plugged, indicating where the mud fluid was placed and the method or methods used in introducing it into the hold. If cement or other plugs were used, state the character of same and depth placed, from _____ feet to _____ feet for each plug set.

Pumped With Allied cementers 3 hulls 10 jell 1 hulls 100 sx.
50-50 poz cement

(If additional description is necessary, use BACK of this sheet)

Name of Plugging Contractor Nicholas Casing Pulling
Box 373 Geneseo Kansas 67444

STATE OF KANSAS COUNTY OF RICE, ss.
George A. Nicholas (employee of owner) or (owner or operator)
of the above-described well, being first duly sworn on oath, says: That I have knowledge of the facts, statements, and matters herein contained and the log of the above-described well as filed and that the same are true and correct. So help me God.

(Signature)

George A. Nicholas

(Address)

SUBSCRIBED AND SWORN TO before me this 9th day of August, 19 79



STEVEN K. PRICKETT
Rice County, Ks.
My Appt. Exp. Aug. 29, 1982

My commission expires August 29, 1982

Steven K Prickett

Notary Public.

RECEIVED
STATE CORPORATION COMMISSION

AUG 10 1979 8-10-79

CONSERVATION DIVISION
Wichita, Kansas

15-009-15062-00-00

Company - SORIO PRODUCING CO
Farm - Dolechek No. 1

SEC. 29
SW 34

T. 14

R. 11

15-009/5062

Total Depth. 3335'
Comm. 7-29-45
Sp. or Treated.
Contractor.
Drilled. 11-10-45

Comp. 8-16-45

Cont.

Section
KANSAS



CASING

8" 535'
6" 3328'

Stratigraphic

Production.

Oil. 105.80 plus
gas

Figures indicate Bottom of Formation

surface clay	0-10	10
shale & shells	130	130
shale, shells & iron	260	260
sand & iron	340	340
shale, shells & iron	480	480
shale & red bed	530	530
red rock	600	600
red bed	750	750
anhydrite	780	780
shale-shells	860	860
shale, salt, shells	980	980
shale & shells	1060	1060
red rock	1078	1073
salt, shale & shells	1380	1380
shale & lime	1605	1605
red lime & shale	1720	1730
shale & lime	2618	2618
iron	2638	2636
shale & lime	2740	2740
lime	2802	2802
lime & shale	2843	2843
lime	2898	2893
lime brick	2964	2964
shale & lime	3217	3217
lime	3335	3335
Total Depth.		

Topo:	
Anhydrite	750
Topokm	2668
ensing	3057
Arbuckle	3328

RECEIVED
STATE CORPORATION COMMISSION
JUL 19 1979
CONSERVATION DIVISION
Wichita, Kansas