

STATE OF KANSAS
STATE CORPORATION COMMISSION


WELL PLUGGING RECORD

Give All Information Completely
Make Required Affidavit
Mail or Deliver Report to:
Conservation Division
State Corporation Commission
800 Bittling Building
Wichita, Kansas

OR
FORMATION PLUGGING RECORD

Strike out upper line
when reporting plug-
ging of formations.

NORTH

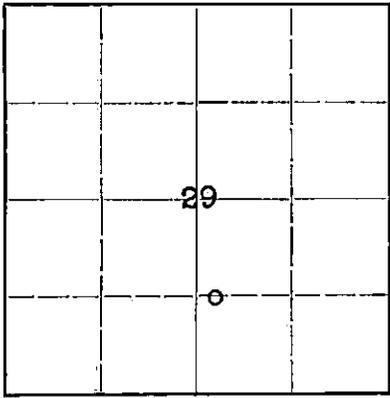

Locate well correctly on above
Section Plat

Barton County, Sec. 29 Twp. 16S Rge. (7) 11(W)
Location as "NE $\frac{1}{4}$ NW $\frac{1}{4}$ SW $\frac{1}{4}$ " or footage from lines C. W/2 W/2 of SE/4
Lease Owner Sohio Petroleum Company
Lease Name Dolechek Well No. 4
Office Address Box 609, Russell, Kansas
Character of Well (completed as Oil, Gas or Dry Hole) Dry hole
Date well completed September 1, 19 45
Application for plugging filed September 2, 19 45
Application for plugging approved Sept. 2 by telephone from H. Kerr 19 45
Plugging commenced September 2, 19 45
Plugging completed September 2, 19 45
Reason for abandonment of well or producing formation Dry hole

If a producing well is abandoned, date of last production _____ 19 ____
Was permission obtained from the Conservation Division or its agents before plugging was com-
menced? Yes by telephone from Herb Kerr

Name of Conservation Agent who supervised plugging of this well Herb Kerr Great Bend, Kansas
Producing formation _____ Depth to top _____ Bottom _____ Total Depth of Well 3371 Feet
Show depth and thickness of all water, oil and gas formations.

OIL, GAS OR WATER RECORDS

CASING RECORD

Formation	Content	From	To	Size	Put In	Pulled Out
No commercial Gas or Oil pays from top of hole to bottom.				8-5/8"	537'	None

Describe in detail the manner in which the well was plugged, indicating where the mud fluid was placed and the method or methods used in introducing it into the hold. If cement or other plugs were used, state the character of same and depth placed, from _____ feet to _____ feet for each plug set.

3371' to 535' heavy mud.
535' plug with 15 sacks cement on top of plug.
Heavy mud to 25' - Set plug with 10 sacks cement.

9-11-45

STATE OF KANSAS
CONSERVATION
DIVISION
SEP 11 1945

29 16 11W
26

(If additional description is necessary, use BACK of this sheet)

Correspondence regarding this well should be addressed to Sohio Petroleum Company
Address Box 609, Russell, Kansas

STATE OF Kansas, COUNTY OF Russell, ss.
P. C. Musgrove (employee of owner) or (~~owner operator~~) of the above-described well,
being first duly sworn on oath, says: That I have knowledge of the facts, statements, and matters herein contained and the log of the above-described well as filed and that the same are true and correct. So help me God.

(Signature) P.C. Musgrove
Box 609, Russell, Kansas
(Address)

SUBSCRIBED AND SWORN TO before me this 7th day of September, 19 45.

My commission expires May 8, 1948.
My commission expires _____
Bernie J. Smith Notary Public.

15-059-05576-00-00
 CONTRACTOR'S VERIFIED LOG

Operator Sohio Petroleum Co. Farm Name Dobouhock Well No. 4
 Location ~~XXXXXXXXXXXX~~ C. W/2 W/2 of SE/4 Sec. 29 Twp. 16S Range 11 W.
 Pool Name _____ County Barton State Kansas
 Commencement Date August 19, 1945 Completion Date September 2, 1945

LOG OF WELL

Depth		Formation	Deviation from Vertical (Degrees)	Remarks
From	To			
0'	15'	Surface Clay & Sand Stone		
15'	80	Shale & Shells		
80	280	Shale, Shells, Iron		
280	360	Sand, Iron, Shale		
360	535	Iron, Shells, Shale		
535	755	Red Rock		
755	785	Antygrite		
785	1030	Shale & shells		
1030	1350	Shale, Shells, Salt		
1350	1465	Shale & Shells		
1465	1880	Lime & Shale		
1880	1950	Lime		
1950	2235	Lime & Shale		
2235	2485	Shale & Shells		
2485	2740	Shale & Lime		
2740	2968	Lime		
2968	3017	Lime & Shale		
3017	3138	Lime		
3138	3278	Lime & Shale		
3278	3331	Lime		
3331	3373	Cherty Conglomerate		

29 16 11 U
 26

