


STATE OF KANSAS  
STATE CORPORATION COMMISSION

WELL PLUGGING RECORD

Give All Information Completely  
Make Required Affidavit  
Mail or Deliver Report to  
Conservation Division  
State Corporation Comm.  
245 North Water  
Wichita, KS 67202

Pawnee County, Sec. 25 Twp. 22S Rge. 16W E7W  
Location as "NE/CNW 1/4 SW 1/4" or footage from lines  
C SW SW

Lease Owner Alpine Drilling Co., Inc.  
Lease Name Doll Well No. 1  
Office Address 800 Bitting Bldg., Wichita KS 67202  
Character of Well (Completed as Oil, Gas or Dry Hole) dry hole

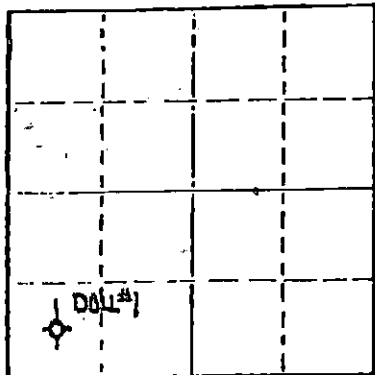

Locate well correctly on above  
Section Plat

Date Well completed September 27 1979  
Application for plugging filed September 27 1979  
Application for plugging approved September 27 1979  
Plugging commenced September 27 1979  
Plugging completed September 27 1979  
Reason for abandonment of well or producing formation

If a producing well is abandoned, date of last production 19

Was permission obtained from the Conservation Division or its agents before plugging was commenced? yes

Name of Conservation Agent who supervised plugging of this well Marion Schmidt, Hays  
Producing formation ~ Depth to top ~ Bottom ~ Total Depth of Well 4082  
Show depth and thickness of all water, oil and gas formations.

OIL, GAS OR WATER RECORDS

CASING RECORD

FORMATION	CONTENT	FROM	TO	SIZE	PUT IN	PULLED OUT

Describe in detail the manner in which the well was plugged, indicating where the mud fluid was placed and the method or methods used in introducing it into the hold. If cement or other plugs were used, state the character of same and depth placed, from feet to feet for each plug set.

Plugged hole as follows:

Filled hole w/mud, pumped 60 sx 50/50 pozmix 4% gel thru open end D.P. @640'; mud to 280'; pumped 30 sx thru open end D.P., mud to 40'; 1/2 sx hulls & wood plug for solid bridge; pumped 10 sx to base of cellar; 5 sx in rathole; completed @ 7:15 a.m. 9-27-79 by Sun.

Witnessed: Marion Schmidt St. Plugger - Hays.  
Gary Bagby, Sterling, Kansas

RECEIVED  
STATE CORPORATION COMMISSION

(If additional description is necessary, use BACK of this sheet) 10-2-79

Name of Plugging Contractor Husky Drilling Co., Inc.

STATE OF KANSAS COUNTY OF SEDGWICK, ss.  
Jon T. Williams, Jr. (employee of owner) or (owner or operator)  
of the above-described well, being first duly sworn on oath, says: That I have knowledge of the facts, statements, and matters herein contained and the log of the above-described well as filed and that the same are true and correct. So help me God.


(Signature)

800 Bitting Bldg., Wichita, KS 67202  
(Address)

SUBSCRIBED AND SWORN TO before me this 1st day of October, 19 79

Geraldine Stewart  
Geraldine Stewart Notary Public.

My commission expires January 12, 1981

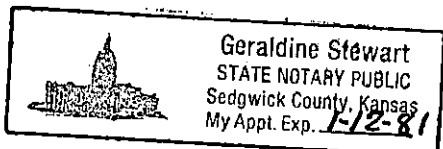



800 Bitting Bldg  
 Wichita, Kansas 67202  
 Phone 316 - 263-7904  
 Mobile Phone 316 - 793-7859 Unit 7070

October 1, 1979

WELL LOG- - - - - Doll No. 1  
 Located: C SW SW of Sec. 25-22S-16W, Pawnee Co., Kansas

OWNER: Alpine Drilling Co., Inc.  
 ROTARY CONTRACTOR: Husky Drilling Co., Inc.

COMMENCED: September 21, 1979  
 COMPLETED: September 27, 1979

Rotary Total Depth: 4082'

<u>LOG</u>		<u>Casing Record</u>
0 - 198	Surface soil & sand	Ran 7 jts., 8-5/8", 28#, 3V, Rge 3, used csg., tallied 279.92', set @ 287' KB w/225 sx common, 2% gel, 3% cc - circulated - plug down @ 12:45 p.m. 9-21-79 by Sun.
198 - 290	Shale	
290 - 450	Shale & sand slks	
450 - 520	Sand	
520 - 986	Red Bed & shale	
986 - 1014	Anhydrite	
1014 - 1640	Shale & shells	
1640 - 3795	Shale & lime	
3795 - 4010	Lime	
4010 - 4020	Chert	
4020 - 4047	Lime	Plugged & Abandoned 9-27-79.
4047 - 4082	Shale	

RECEIVED  
 STATE CORPORATION COMMISSION

OCT - 2 1979

CONSULTING DIVISION  
 Wichita, Kansas