


STATE OF KANSAS  
STATE CORPORATION COMMISSION  
CONSERVATION DIVISION  
P. O. BOX 17027  
WICHITA, KANSAS 67217

FORM CP-4

WELL PLUGGING RECORD

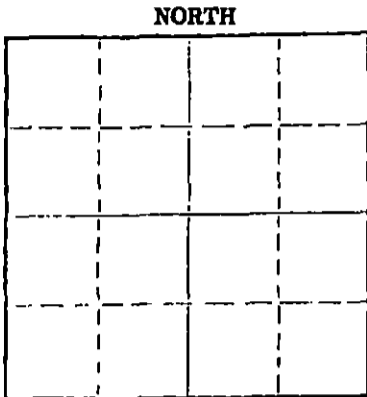

Pawnee County, Sec. 19 Twp. 22 Rge. 16 (E) (W)  
Location as "NE/CNW&SW" or footage from lines NE NE NE  
Lease Owner Sterling Drilling Company  
Lease Name Ewing #1 Well No. \_\_\_\_\_  
Office Address Sterling, Kansas 67579  
Character of Well (completed as Oil, Gas or Dry Hole) \_\_\_\_\_  
Date well completed \_\_\_\_\_ 19\_\_\_\_  
Application for plugging filed \_\_\_\_\_ 19\_\_\_\_  
Application for plugging approved \_\_\_\_\_ 19\_\_\_\_  
Plugging commenced 12/15/75 \_\_\_\_\_ 19\_\_\_\_  
Plugging completed 12/20/75 \_\_\_\_\_ 19\_\_\_\_  
Reason for abandonment of well or producing formation depleted.  
If a producing well is abandoned, date of last production \_\_\_\_\_ 19\_\_\_\_  
Was permission obtained from the Conservation Division or its agents before plugging was commenced? yes

Name of Conservation Agent who supervised plugging of this well Massey  
Producing formation \_\_\_\_\_ Depth to top \_\_\_\_\_ Bottom \_\_\_\_\_ Total Depth of Well 4105 feet  
Show depth and thickness of all water, oil and gas formations.

OIL, GAS OR WATER RECORDS

CASING RECORD

FORMATION	CONTENT	FROM	TO	SIZE	PUT IN	PULLED OUT
				8-5/8	1030	none
				4 1/2	4104	3116'

Describe in detail the manner in which the well was plugged, indicating where the mud fluid was placed and the method or methods used in introducing it into the hole. If cement or other plugs were used, state the character of same and depth placed, from \_\_\_\_\_ feet to \_\_\_\_\_ feet for each plug set.

Pumped 35 sacks cement on bottom, displaced to 3700'.  
Checked hole, top of cement 3700'. Shot pipe at 3302', 3160',  
pulled 94 joints. Pumped 25 sacks gel, 1 sack hulls, 125 sacks  
60-40 pos cement.  
PLUGGING COMPLETE.


(If additional description is necessary, use BACK of this sheet)  
Name of Plugging Contractor KELBO CASING PULLING  
Address CHASE, KANSAS

STATE OF KANSAS COUNTY OF RICE, ss.  
R. DARRELL KELSON (employee of owner) or (owner or operator) of the above-described well, being first duly sworn on oath, says: That I have knowledge of the facts, statements, and matters herein contained and the log of the above-described well as filed and that the same are true and correct. So help me God.

(Signature) R. Darrell Kelson  
CHASE, KANSAS  
(Address)

SUBSCRIBED AND SWORN TO before me this 22nd day of December, 19 75

My commission expires \_\_\_\_\_  
Margaret Melcher  
Notary Public.

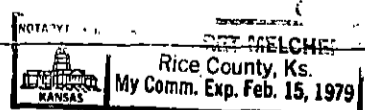

RECEIVED  
STATE CORPORATION COMMISSION  
JAN 26 1975  
CONSERVATION DIV.  
WICHITA, KANSAS

12-26-75

*W*

STERLING DRILLING COMPANY  
 P. O. Box 123  
 Sterling, Kansas 67157

Well No. ----- WELLING #1  
 Located: NE NE NE, Section 19-22E-10, LeFlore County, Kansas

OWNER: Voyager Petroleum, Inc., Kansas-Nebreska Natural Gas Company, Inc. and  
 Sterling Drilling Company  
 ROYALTY DRILLING CONTRACTOR: Sterling Drilling Company

COMMENCED: March 9, 1975  
 COMPLETED: March 20, 1975

TOTAL DEPTH: 4105'

LOG		CASING RECORD
0 - 70	Sand and Gravel	Ran 27 joints used 28" 8 5/8" used casing, 1015.22' set at 1026' K.B. with 550 sacks 50/50 Pozmix with 3% cc. Plug down at 12:45 PM, 3-10-75.
70 - 287	Shale with sand stringers	
287 - 1063	Shale	
1063 - 1087	Anhydrite	
1087 - 2070	Shale and Shells	
2070 - 2173	Lime	
2173 - 3215	Lime and Shale	
3215 - 3580	Lime	
3580 - 3638	Lime and Shale	
3638 - 3985	Lime	
3985 - 4050	Lime and Chert	
4050 - 4105	Lime, Shale, Sand	Ran 12h joints 1 1/2" 10.5# new cementless casing, 4107.70' set at 4104' K.B. Cemented with 150 sacks salt saturated Pozmix #1 with 10 barrels salt flush ahead of cement. Plug down at 5:45 AM, 3-20-75.

RECEIVED  
 STATE CORPORATION COMMISSION  
 NOV 10 1975  
 CONSERVATION DIVISION  
 Wichita, Kansas