


STATE OF KANSAS
STATE CORPORATION COMMISSION

Form CP-4

WELL PLUGGING RECORD

Give All Information Completely
Make Required Affidavit
Mail or Deliver Report to:
Conservation Division
State Corporation Commission
212 No. Market
Wichita, Kansas

NORTH

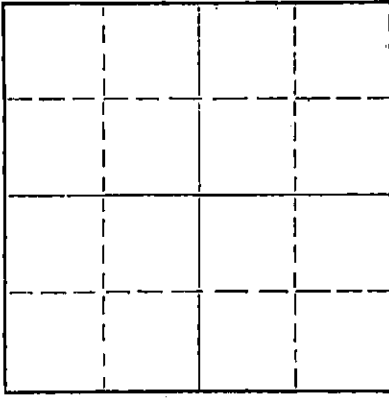

Locate well correctly on above
Section Plat

Pawnee County. Sec. 24 Twp. 22S Rge. 18 KEY (W)
Location as "NE/CNW/SW" or footage from lines 330' SNL, 420' EWL, NW 1/4
Lease Owner Bell Brothers
Lease Name Blackwell Well No. 1
Office Address Robinson, Illinois
Character of Well (completed as Oil, Gas or Dry Hole) Dry Hole
Date well completed 10-14 1967
Application for plugging filed 10-14 1967
Application for plugging approved 10-14 1967
Plugging commenced 10-14 1967
Plugging completed 10-14 1967
Reason for abandonment of well or producing formation Dry Hole

If a producing well is abandoned, date of last production _____ 19____
Was permission obtained from the Conservation Division or its agents before plugging was commenced? Yes

Name of Conservation Agent who supervised plugging of this well Leo Massey
Producing formation _____ Depth to top _____ Bottom _____ Total Depth of Well _____ Feet
Show depth and thickness of all water, oil and gas formations.

OIL, GAS OR WATER RECORDS

CASING RECORD

FORMATION	CONTENT	FROM	TO	SIZE	PUT IN	PULLED OUT

Describe in detail the manner in which the well was plugged, indicating where the mud fluid was placed and the method or methods used in introducing it into the hole. If cement or other plugs were used, state the character of same and depth placed, from _____ feet to _____ feet for each plug set.

Halliburton plug and 125 sacks 50-50 Pos pumped into surface pipe


11-28-67

RECEIVED
STATE CORPORATION COMMISSION
NOV 28 1967
CONSERVATION DIVISION
WICHITA, KANSAS

(If additional description is necessary, use BACK of this sheet)

Name of Plugging Contractor Peel Brothers, Inc.
Address WILLIAMSON Box 359, Hoisington, Kansas 67544

Peel Brothers, Inc. _____, COUNTY OF Barton, ss.
(employee of owner) or (owner or operator) of the above-described well, being first duly sworn on oath, says: That I have knowledge of the facts, statements, and matters herein contained and the log of the above-described well as filed and that the same are true and correct. So help me God. PEEL BROTHERS, INC.
(Signature) Wendell C. Peel
Wendell C. Peel, President
(Address)

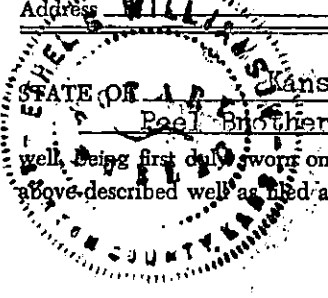

SUBSCRIBED AND SWORN to before me this 18th day of October, 19 67

My commission expires 6-21-70
Ethel S. Williamson
Ethel S. Williamson Notary Public.

DRILLER'S LOG

Well Owner: Bell Brothers
 Farm Name: Blackwell No. 1
 Date Started: 9-25-67
 Date Completed: 10-14-67
 Total Depth: 4528

NW $\frac{1}{4}$
 Section 24-22S-18W
 Pawnee County, Kansas

Casing: 8-5/8" set at 291' cemented

Contractor: Peel Brothers, Inc.

Figures below are the bottoms of the formations -

Clay	0	-	70
Clay and Sand			100
Sand			655
Red Bed and Shells			910
Anhydrite			1142
Shale and Shells			1190
Shale			1610
Shale and Lime			2070
Chert			4165
Cherty Lime			4202
Lime and Chert			4345
Lime and Shale			4418
Lime			4528
Total Depth			4528

RECEIVED
 STATE CORPORATION COMMISSION

NOV 22 1967

CONSE
 DIVISION
 Kansas

This is to certify that the above information is to the best of our knowledge true and correct.

PEEL BROTHERS, INC.

Wendell C. Peel
 Wendell C. Peel
 President

SUBSCRIBED AND SWORN to before me this 18th day of October, 1967.

Ethel S. Williamson
 Ethel S. Williamson
 Notary Public

My Commission expires 6-21-70