

STATE OF KANSAS  
STATE CORPORATION COMMISSION

WELL PLUGGING RECORD

Give All Information Completely  
Make Required Affidavit  
Mail or Deliver Report to  
Conservation Division  
State Corporation Comm.  
245 North Water  
Wichita, KS 67202

Pawnee County, Sec. 2 Twp. 22S Rge. 15W  
Location as "NE/CNW $\frac{1}{4}$ SW $\frac{1}{4}$ " or footage from lines  
NW SW NE

Lease Owner F & M OIL CO., INC.  
Lease Name Blackwell Well No. 1

Office Address 422 Union Center, Wichita, Ks. 67202

Character of Well (Completed as Oil, Gas or Dry Hole)  
Dry Hole






Reason for abandonment of well or producing formation  
Dry


If a producing well is abandoned, date of last production  
19

Was permission obtained from the Conservation Division or  
its agents before plugging was commenced? Yes

Name of Conservation Agent who supervised plugging of this well Leo Massey

Producing formation \_\_\_\_\_ Depth to top \_\_\_\_\_ Bottom \_\_\_\_\_ Total Depth of Well \_\_\_\_\_

Show depth and thickness of all water, oil and gas formations.

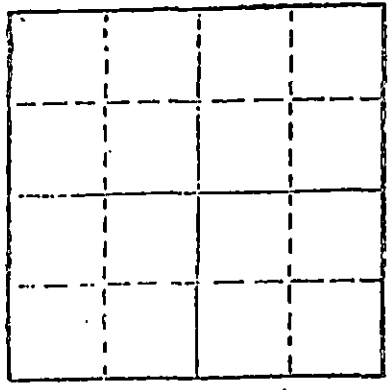

Locate well correctly on above  
Section Plot

OIL, GAS OR WATER RECORDS

CASING RECORD

| FORMATION | CONTENT | FROM | TO | SIZE | PUT IN | PULLED OUT |
|-----------|---------|------|----|------|--------|------------|
|           |         |      |    |      |        |            |
|           |         |      |    |      |        |            |
|           |         |      |    |      |        |            |
|           |         |      |    |      |        |            |

Describe in detail the manner in which the well was plugged, indicating where the mud fluid was placed and the method or methods used in introducing it into the hold. If cement or other plugs were used, state the character of same and depth placed, from \_\_\_\_\_ feet to \_\_\_\_\_ feet for each plug set.

- Set 1st plug at 620' with 70 sacks
- Set 2nd plug at 240' with 25 sacks
- Set 3rd plug at 40' with 10 sacks
- 5 sacks in the rat hole

(If additional description is necessary, use BACK of this sheet)

Name of Plugging Contractor \_\_\_\_\_


STATE OF Kansas COUNTY OF Sedgwick, ss.  
R. D. Messinger (employee of owner) or (owner or operator)  
of the above-described well, being first duly sworn on oath, says: That I have knowledge of the facts, statements, and matters herein contained and the log of the above-described well as filed and that the same are true and correct. So help me God.

(Signature) R. D. Messinger  
422 Union Center, Wichita, Kansas 67202  
(Address)

SUBSCRIBED AND SWORN TO before me this 14th day of January, 19 81

My commission expires 12-24-84

Shirley A. Gallegos Notary Public.

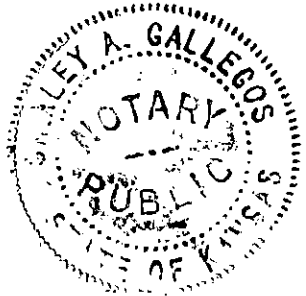

RECEIVED  
STATE CORPORATION COMMISSION  
JAN 19 1981  
1-19-81  
CONSERVATION DIVISION  
Wichita, Kansas