


STATE OF KANSAS
STATE CORPORATION COMMISSION

WELL PLUGGING RECORD

Give All Information Completely
Make Required Affidavit
Mail or Deliver Report to
Conservation Division
State Corporation Comm.
245 North Water
Wichita, KS 67202

Pawnee County. Sec. 3 Twp. 22 Rge. 15 E/W
Location as "NE/CNW $\frac{1}{4}$ /SW $\frac{1}{4}$ " or footage from lines
NW NE SE

Lease Owner Hummen Oil Company
Lease Name Ruby Compton #1 Well No. _____
Office Address Wichita, Kansas
Character of Well (Completed as Oil, Gas or Dry Hole) _____

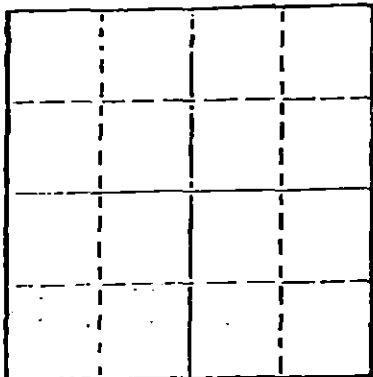

Locate well correctly on above
Section Plat

Date Well completed _____ 19____
Application for plugging filed _____ 19____
Application for plugging approved _____ 19____
Plugging commenced 11/18/76 _____ 19____
Plugging completed 11/24/76 _____ 19____
Reason for abandonment of well or producing formation
depleted. _____

If a producing well is abandoned, date of last production
_____ 19____

Was permission obtained from the Conservation Division or
its agents before plugging was commenced? yes _____

Name of Conservation Agent who supervised plugging of this well Massey
Producing formation _____ Depth to top _____ Bottom _____ Total Depth of Well 3949
Show depth and thickness of all water, oil and gas formations.

OIL, GAS OR WATER RECORDS

CASING RECORD

FORMATION	CONTENT	FROM	TO	SIZE	PUT IN	PULLED OUT
				8-5/8	292	none
				5 1/2"	3934	3045'

Describe in detail the manner in which the well was plugged, indicating where the mud fluid
was placed and the method or methods used in introducing it into the hold. If cement or other
plugs were used, state the character of same and depth placed, from _____ feet to
_____ feet for each plug set.

Pushed wood plug to 3600', sanded to 3590' with 4 sacks cement. Well flowed for 3 hrs.,
15 barrels per hour. Had collar welded and had long string loaded with water. Pumped
60 weight and 20 gel to kill dakota water. Shot pipe at 3113', 3022', pulled 103 joints.
Took control head off and put swedge on. Allied plugged well with 125 sacks cement.
PLUGGING COMPLETE. RECEIVED
STATE CORPORATION COMMISSION

DEC 01 1976
12-1-76

(If additional description is necessary, use BACK of this SHEET) DIVISION
Name of Plugging Contractor KHELSON CASING PULLING Wichita, Kansas
CHASE, KANSAS

STATE OF KANSAS COUNTY OF RICE, ss.
R. DARRELL KELSO (employee of owner) or (owner or operator)
of the above-described well, being first duly sworn on oath, says: That I have knowledge of
the facts, statements, and matters herein contained and the log of the above-described well
as filed and that the same are true and correct. So help me God.

(Signature) R. Darrell Kelso
CHASE, KANSAS
(Address)

SUBSCRIBED AND SWORN TO before me this 29th day of November, 19 76

Margaret Melcher
Notary Public.

My commission expires

