

TYPE OR PRINT
 NOTICE: Fill out completely
 and return to Cons. Div.
 office within 30 days.

LEASE NAME Burmeister
 WELL NUMBER #4

 Ft. from S Section Line
 Ft. from E Section Line

LEASE OPERATOR SID TOMLINSON
Rt. #4 Box 7695
 ADDRESS Twin Falls, ID 83301

SEC. 27 TWP. 16 RGE. 11W (E) or (W)
 COUNTY Barton

PHONE# (208) 734-9329 OPERATORS LICENSE NO. 6412

Date Well Completed

Character of Well

Plugging Commenced 9/2/88

(Oil, Gas, D&A, SWD, Input, Water Supply Well)

Plugging Completed 9/20/88

The plugging proposal was approved on 9/20/88 (date)
 by Gib Scheck (KCC District Agent's Name).

Is ACO-1 filed? If not, is well log attached?

Producing Formation Depth to Top Bottom T.D.

Show depth and thickness of all water, oil and gas formations.

OIL, GAS OR WATER RECORDS

CASING RECORD

Formation	Content	From	To	Size	Put In	Pulled out
				8 5/8	365	none
				5 1/2	3436	2402

Describe in detail the manner in which the well was plugged, indicating where the mud fluid was placed and the method or methods used in introducing it into the hole. If cement or other plugs were used, state the character of same and depth placed, from feet to feet each set. Plugged bottom with sand to 2950', ran 5 sacks cement, shot @2402', plugged surface with 400# hulls, 200 sacks cement 60/40/pos, 6% gel.

(If additional description is necessary, use BACK of this form.)

Name of Plugging Contractor KELSO CASING PULLING, INC. License No. 6050

Address P.O. box 347 Chase, KS 67524

NAME OF PARTY RESPONSIBLE FOR PLUGGING FEES: SID TOMLINSON

STATE OF Kansas COUNTY OF Rice, ss.

R. Darrell Kelso (Employee of Operator) or (Operator) of above-described well, being first duly sworn on oath, says: That I have knowledge of the facts, statements, and matters herein contained and the log of the above-described well as filed that the same are true and correct, so help me God.

(Signature) [Signature]
 (Address) P.O. Box 347 Chase, Ks 67524

SUBSCRIBED AND SWORN TO before me this 22nd day of September, 19 88

[Signature]
 Notary Public

My Commission Expires:



KANSAS DRILLERS LOG

S. 27 T. 16 R. 11 *
 W
 Loc. 165 E C NW, SE SE
 County Barton

API No. 15 — 009 — 20,811
 County Number

Operator Sid Tomlinson Oil & Gas Operations

Address Box 594, Twin Falls, Idaho 83301


Well No. #4 Lease Name Burmeister

Footage Location 990 feet from (S) line 825 feet from (E) (line) SE/4

Principal Contractor Red Tiger Drilling Geologist J. E. Jespersen

Spud Date 7-19-74 Total Depth 3437 P.B.T.D. 3411

Date Completed 12-14-74 Oil Purchaser Phillips

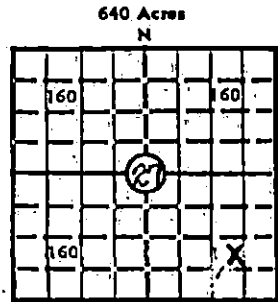

Elev.: Gr. 1924
 DF 1927 KB 1929

CASING RECORD

Report of all strings set — surface, intermediate, production, etc.

Purpose of string	Size hole drilled	Size casing set (in O.D.)	Weight lbs/ft.	Setting depth	Type cement	Sacks	Type and percent additives
Surface	12 1/4	8 5/8	28	365	common	250	3 % CaCl
Production	7 7/8	5 1/2	14	3436	Pozmix	125	18% salt

RECEIVED
 STATE CORPORATION COMMISSION
 AUG 30 1988
 CONSERVATION DIVISION
 Wichita Kansas

LINER RECORD

PERFORATION RECORD

Top, ft.	Bottom, ft.	Sacks cement	Shots per ft.	Size & type	Depth Interval
			4	Jumbo Jet	3380-86
			4	" "	2988-90

TUBING RECORD

Size	Setting depth	Packer set at
2 3/8	3384	none

ACID, FRACTURE, SHOT, CEMENT SQUEEZE RECORD

Amount and kind of material used	Depth Interval treated
500 gals 15% NE acid	3380-86
500 gals 15% NE acid	2988-90

INITIAL PRODUCTION

Date of first production <u>10-23-74</u>	Producing method (flowing, pumping, gas lift, etc.) <u>Pumping</u>
RATE OF PRODUCTION PER 24 HOURS	Oil <u>20</u> bbls. Gas <u>0</u> MCF Water <u>150</u> bbls. Gas-oil ratio <u>CFPB</u>
Disposition of gas (vented, used on lease or sold)	Producing interval (s) <u>3380-86, 2988-90</u>

INSTRUCTIONS: As provided in KCC Rule 82-2-125, within 90 days after completion of a well, one completed copy of this Drillers Log shall be transmitted to the State Geological Survey of Kansas, 4150 Monroe Street, Wichita, Kansas 67209. Copies of this form are available from the Conservation Division, State Corporation Commission, 3830 So. Meridian (P.O. Box 17027), Wichita, Kansas 66217. Phone AC 316-522-2206. If confidential custody is desired, please note Rule 82-2-125. Drillers Logs will be on open file in the Oil and Gas Division, State Geological Survey of Kansas, Lawrence, Kansas 66044.