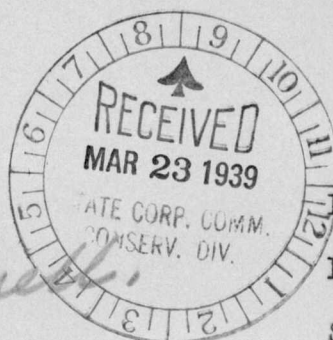


TO
STATE CORPORATION COMMISSION
CONSERVATION DIVISION
800 Bitting Building
Wichita, Kansas

File 53-2Location near S.W. 1/4
Sec. 24 Twp. 22 Rge. 2 W.

Abandoned Gas well.

I have today completed supervision of plugging of:

Well No. 1 Lease J.J. Eury
Operator Henry Bennett Address Plains Hotel, Augusta, Kansas
Field Sperting County Harvey
Total Depth 3490' Feet. Started plugging 3-1-39.

(Describe briefly the manner in which well was plugged)

Cable tool hole. Plugged back from bottom
@ 3490' to 3142' with Cement & leadwood.
Filled hole with heavy mud between
plugs from 3142' to top of hole.
Plug rock & 15' cement at top of shot at 2960'
to 2945'. Plug rock & 15' cement below fresh

Expense incurred as follows:


Date <u>3-1-39</u>	*Day <u>1/4</u>	Mileage <u>62</u>	(9)
Date <u>3-3-39</u>	*Day	Mileage <u>30</u>	
Date <u>3-6-39</u>	*Day	Mileage <u>35</u>	
Date <u>3-11-39</u>		<u>28</u>	
Hotel, meals, etc. \$		<u>27</u>	
*Show as 1/4, 2/4, 3/4, or 4/4.		<u>27</u>	
<u>3-15-39</u>	<u>1/4</u>	<u>37</u>	<u>buy & shipping</u>
<u>3-17-39</u>		<u>48</u>	Conservation Agent
<u>3-20-39</u>		<u>60</u>	
<u>3-22-39</u>		<u>3-22-39.</u>	

P. O. Sperting Kansas

Date

water @ 200' ^{1/2} Plug rock & 10' cement @
base of Celler.

Mr Henry Bennett, Plains Hotel
Augusta Kansas. In charge for Operator.

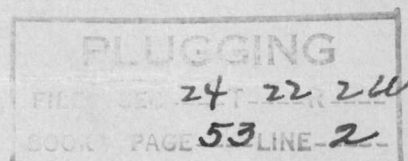

Henry Bennett
Moundridge