


Give All Information Completely
Make Required Affidavit
Mail or Deliver Report to:
Conservation Division
State Corporation Commission
800 Biting Building
Wichita, Kansas

WELL PLUGGING RECORD

NORTH

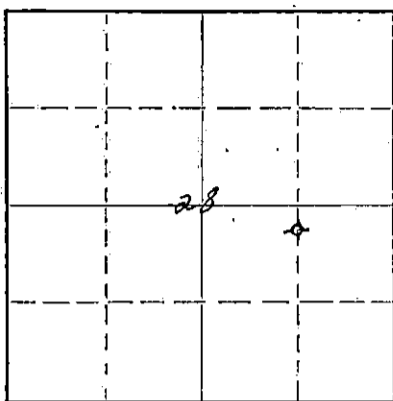

Locate well correctly on above
Section Plat

Barton County, Sec. 28 Twp. 16 Rge. 11 (E) W (W)
Location as "NE/CNW $\frac{1}{4}$ SW $\frac{1}{4}$ " or footage from lines N/2 N/2 SE/4
Lease Owner National Cooperative Refinery Association
Lease Name Esfeld Well No. 9
Office Address 820 Union National Bank Bldg, Wichita, Kansas
Character of Well (completed as Oil, Gas or Dry Hole) Dry
Date well completed 2-12 19 51
Application for plugging filed 2-11 19 51
Application for plugging approved 2-11 19 51
Plugging commenced 2-11 19 51
Plugging completed 2-12 19 51
Reason for abandonment of well or producing formation Non-Productive
If a producing well is abandoned, date of last production 19
Was permission obtained from the Conservation Division or its agents before plugging was commenced? Yes

Name of Conservation Agent who supervised plugging of this well C. D. Slough
Producing formation Non-producing Depth to top Bottom Total Depth of Well 3372 Feet
Show depth and thickness of all water, oil and gas formations.

OIL, GAS OR WATER RECORDS

CASING RECORD

Formation	Content	From	To	Size	Put In	Pulled Out
All Zones proved to be Non-productive				8-5/8"	762	None (Cemented)

Describe in detail the manner in which the well was plugged, indicating where the mud fluid was placed and the method or methods used in introducing it into the hole. If cement or other plugs were used, state the character of same and depth placed, from feet to feet for each plug set.

Hole was filled with Heavy mud from 3372 back up to 270 ft. where a bridge was placed at this depth and cemented back to 222 ft. using 15 sacks of cement. Filled with heavy mud, from 222 feet back up to 32 feet. Bridge placed at this depth and cemented back up to top of surface and cellar base using 10 sacks of cement.

2-17-51

RECEIVED
STATE CORPORATION COMMISSION
FEB 17 1951
CONSERVATION DIVISION
Wichita, Kansas

(If additional description is necessary, use BACK of this sheet)

Correspondence regarding this well should be addressed to National Cooperative Refinery Ass'n.
Address 820 Union National Bank Building, Wichita, Kansas

STATE OF Kansas, COUNTY OF Sedgwick, ss.
James C. Hogwood (employee of owner) or (owner or operator) of the above-described well,
being first duly sworn on oath, says: That I have knowledge of the facts, statements, and matters herein contained and the log of the above-described well as filed and that the same are true and correct. So help me God.

(Signature) James C. Hogwood
(Address)

SUBSCRIBED AND SWORN TO before me this 15th day of February, 19 51

I. A. Lange
Notary Public.

My commission expires February 20, 1953

PLUGGING
FILE SEC 287-46-116
BOOK PAGE 61 LINE 28

ESFELD #9
 Section 28, Township 16, Range 11 West
 Barton, County, Kansas
 Operator - National Cooperative Refinery Association
 Contractor - J. W. Braden Drilling Company
 Test Started - January 29, 1951
 Test Finished - February 12, 1951

Ctd 2200 SS Greider

Surface	0	to	60	
Shale & Shells	60	"	190	
Shale	190	to	752	
Anhydrite	752	to	790	
Shale & Shells	790	to	1240	
Salt	1240	to	1370	
Shale	1370	to	1490	
Shale & Lime	1490		1770	
Lime	1770		2070	
Lime & Shale	2070		2250	
Shale & Sand	2250		2500	
Shale & Shells	2500		2700	
Shale & Sand	2700		2775	
Lime & Shale	2775		2830	
Lime	2830		3223	
Lime & Shale	3223		3255	
Lime	3255		3305	
Lime & Shale	3305		3331	
Lime	3331		3340	
Conglomerate	3340		3352	
Lime	3352		3372	Total Depth

Set 8-5/8" at 701 feet

STATE OF KANSAS)
) SS:
 COUNTY OF RENO)

I hereby certify that the above information is true and correct to the best of my knowledge.

J. W. Braden

Subscribed and sworn to before me this 17th day of March, 1951.

M. L. Bowman
Notary Public.

My Commission expires:
 March 21, 1953

PLICING
 FILE # 28-116-114
 61-28

REC'D
 STATE COMMISSION
 MAR 22 1951
 CONGRESSIONAL DIVISION
 Wichita, Kansas