

STATE OF KANSAS
STATE CORPORATION COMMISSION


WELL PLUGGING RECORD

OR 15-009-19276-0000
FORMATION PLUGGING RECORD

Give All Information Completely
Make Required Affidavit
Mail Deliver Report to:
Conservation Division
State Corporation Commission
800 Bittling Building
Wichita, Kansas

Strike out upper line
when reporting plug-
ging of formations.

NORTH

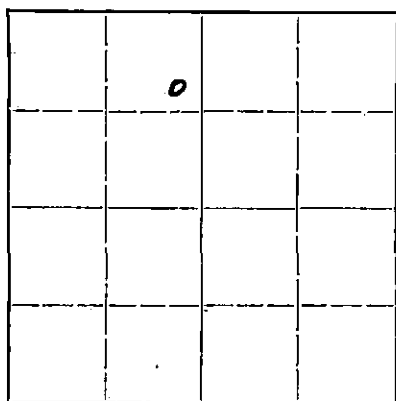

Locate well correctly on above
Section Plat

Barton County. Sec 28 Twp 16 Rge. (E) 11 (W)
Location as "NE $\frac{1}{4}$ NW $\frac{1}{4}$ SW $\frac{1}{4}$ " or footage from lines SE NE NW
Lease Owner G. W. Keyes Drilling Company
Lease Name Seyfert Well No. 1
Office Address Ellinwood, Kansas
Character of Well (completed as Oil, Gas or Dry Hole) Dry Hole
Date well completed Nov. 21 1947
Application for plugging filed Nov. 20 1947
Application for plugging approved Nov. 20 1947
Plugging commenced Nov. 21 1947
Plugging completed Nov. 21 1947
Reason for abandonment of well or producing formation Dry hole
If a producing well is abandoned, date of last production none 19
Was permission obtained from the Conservation Division or its agents before plugging was com-
menced? YES

Name of Conservation Agent who supervised plugging of this well H. Kerr
Producing formation none Depth to top. --- Bottom. --- Total Depth of Well 3416 Feet
Show depth and thickness of all water, oil and gas formations.

OIL, GAS OR WATER RECORDS

CASING RECORD

Formation	Content	From	To	Size	Put In	Pulled Out
Surface Pipe		0	190	8 5/8"	190	none

Describe in detail the manner in which the well was plugged, indicating where the mud fluid was placed and the method or methods used in introducing it into the hold. If cement or other plugs were used, state the character of same and depth placed, from _____ feet to _____ feet for each plug set.

Filled hole with heavy mud from total depth to bottom of surface pipe at 190'; set rock bridge at 190' and cemented with 15 sacks on top of bridge; filled with heavy mud to 15' and cemented with 10 sacks on top of rock bridge set at 15', cement returned to surface.

DEC 6 - 1947

12-Dec-47

(If additional description is necessary, use BACK of this sheet)

Correspondence regarding this well should be addressed to Keyes Drilling Co.
Address Ellinwood, Kansas

STATE OF Kansas, COUNTY OF Barton, ss.
I, G. W. Keyes, Part Owner (employee of owner) of the above-described well,

being first duly sworn on oath, says: That I have knowledge of the facts, statements, and matters herein contained and the log of the above-described well as filed and that the same are true and correct. So help me God.

(Signature) *G. W. Keyes*
Ellinwood, Kansas (Address)

SUBSCRIBED AND SWORN TO before me this 5th day of December, 1947.
George A. Meyer
Notary Public.

My commission expires Feb. 10, 1951.

21-6858-RS 2-47-CM

PLUGGING
FILE SEC 28 T 16 R 110
BOOK PAGE 47
































G. W. KEYES DRILLING COMPANY, OWNER - Seyfert No. 1
 SE NE NW, Section 28, Township 16S, Range 11 West,
 Barton County, Kansas

Elevation 1921 DF		Figures indicate bottom of formation	
		0	to 135 post rock, sand, & shale
			190 sand and shale
			280 shale
			360 sand
			565 shale and sand
			755 red bed
			785 anhydrite
			1000 shale and shells
			1425 shale, salt and shells
			1615 shale and lime
			1675 lime
			1800 shale and shells
			1975 lime
			2210 broken lime
			2745 shale and shells
			2960 lime
			3040 lime and shale
			3360 lime
			3390 conglomerate
			3416 arbuckle
			3416 Total Depth D & A

Tops, corrected 3' to derrick floor

Heebner 2960
 Base Oread 2990
 Brown Lime 3058
 Lansing 3078
 Chert Congl. 3352
 Arbuckle Dol. 3387

Pipe record

8 5/8" set at 190'

Commenced Nov. 10, 1947.
 Completed D & A Nov. 21, 1947

State of Kansas) SS
 County of Barton)

I, G. W. Keyes, Part Owner of the above-described well, being first duly sworn on oath declare: That I have knowledge of the facts, statements and matters herein contained pertaining to the log of the above-described well, as filed, and that the same are true and correct.

Subscribed and Sworn to before me this 5th day of December, 1947.

G. W. Keyes

 DEC 6 - 1947
George A. Meyer

 Notary Public

My Commission expires Feb. 10, 1951.

PLUGGING
 FILE SEC 28 T 16 R 11 W
 BOOK PAGE 1 LINE 7