

STATE OF KANSAS
STATE CORPORATION COMMISSION

WELL PLUGGING RECORD

OR
FORMATION PLUGGING RECORD


Strike out upper line
when reporting plug-
ging of formations.

Give All Information Completely
Make Required Affidavit
Mail or Deliver Report to:
Conservation Division
State Corporation Commission
800 Bating Building
Wichita, Kansas

Stafford County, Sec. 28 Twp. 22 Rge. 12 (W)

Location as "NE $\frac{1}{4}$ NW $\frac{1}{4}$ SW $\frac{1}{4}$ " or footage from lines NE $\frac{1}{4}$ NW $\frac{1}{4}$ SW $\frac{1}{4}$
Lease Owner Harbar Drilling Company
Lease Name Hitz Well No. 1
Office Address 1019 Central Bldg., Wichita, Kansas.
Character of Well (completed as Oil, Gas or Dry Hole) Dry Hole
Date well completed October 19- 19 44
Application for plugging filed October 19- 19 44
Application for plugging approved October 19- 19 44
Plugging commenced October 19- 19 44
Plugging completed October 20- 19 44
Reason for abandonment of well or producing formation Dry Hole
If a producing well is abandoned, date of last production 19
Was permission obtained from the Conservation Division or its agents before plugging was com-
menced? Yes

NORTH

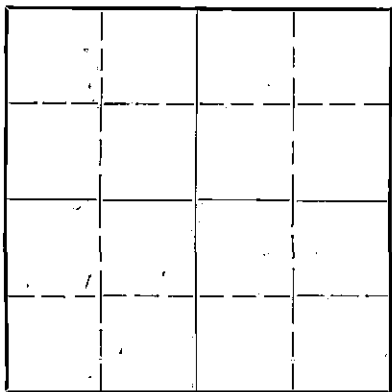

Locate well correctly on above
Section Plat

Name of Conservation Agent who supervised plugging of this well H. W. Kerr,
Producing formation Depth to top Bottom Total Depth of Well 3727 Feet
Show depth and thickness of all water, oil and gas formations.

OIL, GAS OR WATER RECORDS

CASING RECORD

Formation	Content	From	To	Size	Put In	Pulled Out
Surface sand	dry	6	30	10 5/4"	289	None
Water Sand	water	30	95			

Describe in detail the manner in which the well was plugged, indicating where the mud fluid was placed and the method or methods used in introducing it into the hold. If cement or other plugs were used, state the character of same and depth placed, from feet to feet for each plug set.

Permanent Bridge placed @ 290' and hole filled with heavy mud from 3727 to 290' and permanent bridge cemented with 15 sacks of cement. Hole filled with heavy mud from 230' to 26' and permanent plug placed at 26' and cemented with 10 sacks of cement from 26' to 6'. Due to inability to find cement on top of the top plug, and additional 20 sacks of cement were placed in the top of the hole.

PLUGGING
FILE 28 22 120
BOOK 125 38

(If additional description is necessary, use BACK of this sheet)

Correspondence regarding this well should be addressed to Harbar Drilling Company,
Address 1019 Central Building, Wichita, Kansas.

STATE OF Kansas COUNTY OF Sedgwick ss.
Jim Adkins (employee of owner) or (insurance agent) of the above-described well,
being first duly sworn on oath, says: That I have knowledge of the facts, statements, and matters herein contained and the log of the above-described well as filed and that the same are true and correct. So help me God.

(Signature) Jim Adkins 11-22-44
1502-12th Street, Great Bend, Kansas (Address)

SUBSCRIBED AND SWORN to before me this 6th day of November, 19 44.

My commission expires April 7, 1947

Margaret O. Reilly
Notary Public
NOV 22 1944

HARBAR DRILLING COMPANY
 HITZ #1
 CNL NW NW 28-22-12
 Stafford County, Kansas

Rigging up 9-24-44
 Tearing out tools 10-20-44

FORMATION	FROM	TO	REMARKS
Surface dirt sand	0	65	
Sand & shale	65	200	
Shale & shells	200	297	
Red bed	297	635	
Red rock	635	650	
Lime	650	665	
Lime	665	790	
Shale & shells	790	1560	Slope test @ 1000' - O.K.
Lime broken	1560	1610	
Lime	1610	2040	Slope test @ 1700' - 1 degree off
Lime shale	2040	2160	Slope test @ 2000' - 1 degree off
Lime	2160	2350	
Lime shale	2350	2640	Slope test @ 2500' - O.K.
Lime	2640	2675	
Lime broken	2675	2795	Slope test @ 2750' - O.K.
Lime	2795	3270	Slope test @ 3150' - O.K.
Lime & shale	3270	3305	
Lime	3305	3415	
Kansas City	3415	3471	
Lime	3471	3595	
Lime & chert	3595	3615	
Chert	3615	3644	
Cherty lime	3644	3665	
Chert	3665	3669	
Shale	3669	3727	T.D.

Ran 8 jts., 310' of 10 3/4" O. D. Spiral Wold 29 1/2 casing set at 289' with 200 sacks of cement.

I, W. A. Grant, do solemnly swear that the above log is true and correct to the best of my knowledge.

[Signature]

Subscribed and sworn to before me and in my presence this 6th day of November, 1944.

DRILLING
 FILE - 28 22-12-12
 BOOK PAGE 135 LINE 38

[Signature]
 Notary Public

My commission expires
 April 7, 1947

STATE COMMISSION
 NOV 22 1944