


STATE OF KANSAS  
STATE CORPORATION COMMISSION

WELL PLUGGING RECORD

Give All Information Completely  
Make Required Affidavit  
Mail or Deliver Report to:  
Conservation Division  
State Corporation Commission  
212 North Market, Insurance Bldg.  
Wichita, Kansas

Stafford County, Sec. 28 Twp. 22S Rge. ----(E)12-(W)  
Location as "NE/CNW/SW" or footage from lines SE - SE - NE  
Lease Owner Halliburton Oil Producing Company  
Lease Name Felke Well No. 1  
Office Address 520 Cameron Bldg. Oklahoma City 6, Oklahoma  
Character of Well (completed as Oil, Gas or Dry Hole) Dry Hole  
Date well completed 6-23 19 62  
Application for plugging filed 6-23 19 62  
Application for plugging approved 6-23 19 62  
Plugging commenced 6-23 19 62  
Plugging completed 6-23 19 62  
Reason for abandonment of well or producing formation Dry Hole

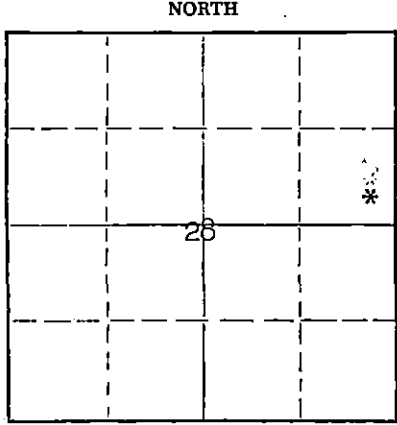

Locate well correctly on above  
Section Plat

If a producing well is abandoned, date of last production ----- 19---  
Was permission obtained from the Conservation Division or its agents before plugging was commenced? Yes

Name of Conservation Agent who supervised plugging of this well Mr. W.L. Tackamp  
Producing formation none Depth to top ----- Bottom ----- Total Depth of Well 3715 Feet  
Show depth and thickness of all water, oil and gas formations.

OIL, GAS OR WATER RECORDS

CASING RECORD

| FORMATION       | CONTENT                | FROM        | TO          | SIZE         | PUT IN      | PULLED OUT |
|-----------------|------------------------|-------------|-------------|--------------|-------------|------------|
| <u>Lansing</u>  | <u>oil &amp; water</u> | <u>3445</u> | <u>3468</u> | <u>8 5/8</u> | <u>241'</u> | <u>0</u>   |
| <u>Arbuckle</u> | <u>water</u>           | <u>3693</u> | <u>3715</u> |              |             |            |
|                 |                        |             |             |              |             |            |
|                 |                        |             |             |              |             |            |
|                 |                        |             |             |              |             |            |

Describe in detail the manner in which the well was plugged, indicating where the mud fluid was placed and the method or methods used in introducing it into the hole. If cement or other plugs were used, state the character of same and depth placed, from ----- feet to ----- feet for each plug set.

Filled hole with heavy mud from T.D. to 220'  
Placed 25 sack cement plug from 220 to 230'  
Ran plug on top of cement & placed hulls on plug  
Filled casing with heavy mud from 130' to 35'  
Placed 10 sack cement plug from 35' to surface  
Placed 2 sack cement plug in rat hole

**RECEIVED**  
STATE CORPORATION COMMISSION  
JUN 27 1962  
CONSERVATION DIVISION  
Wichita, Kansas

6-27-62

(If additional description is necessary, use BACK of this sheet)

Name of Plugging Contractor Sterling Drilling Company  
Address Sterling, Kansas

STATE OF Oklahoma, COUNTY OF Oklahoma, ss.  
D.D. Swearingen (employee of owner) or (owner or operator) of the above-described well, being first duly sworn on oath, says: That I have knowledge of the facts, statements, and matters herein contained and the log of the above-described well as filed and that the same are true and correct. So help me God.

(Signature) D. D. Swearingen  
2915 Classen Blvd., Cameron Bldg.  
(Address)

SUBSCRIBED AND SWORN TO before me this 26th day of June, 1962

Margaret J. Lawrence  
Notary Public.

My commission expires 4-15-66



**STERLING DRILLING COMPANY**  
Sterling, Kansas

WELL LOG ----- Felke #1

Located: SE SE NE of Section 28-22S-12W, Stafford County, Kansas.

OWNER: Halliburton Oil Producing Company  
ROTARY DRILLING CONTRACTOR: Group Exploration Company

COMMENCED: 6-14-62  
COMPLETED: 6-23-62

ROTARY TOTAL DEPTH: 3715'

LOG

|        |      |                         |
|--------|------|-------------------------|
| 0 -    | 170  | Sand & Shale            |
| 170 -  | 252  | Red Bed                 |
| 252 -  | 735  | Shale & Shells          |
| 735 -  | 1575 | Shale, Red Bed & Shells |
| 1575 - | 2420 | Shale & Lime            |
| 2420 - | 2600 | Shale                   |
| 2600 - | 3080 | Lime & Shale            |
| 3080 - | 3160 | Lime                    |
| 3160 - | 3305 | Lime & Shale            |
| 3305 - | 3593 | Lime                    |
| 3593 - | 3645 | Viola                   |
| 3645 - | 3694 | Shale                   |
| 3694 - | 3715 | Ambuckle                |

T.D.

CASING RECORD

Set 8-5/8" Surface Casing @ 248' K.B.  
with 200 sacks M45 cement.

Plugged & Abandoned.

**RECEIVED**  
STATE CORPORATION COMMISSION  
JUN 28 1962  
CONSERVATION DIVISION  
Wichita, Kansas