

Give All Information Completely
Make Required Affidavit
Mail or Deliver Report to:
Conservation Division
State Corporation Commission
211 No. Broadway
Wichita, Kansas

WELL PLUGGING RECORD

Stafford County, Sec. 28 Twp. 22S Rge. 12W (E) (W)

Location as "NE/CNW/SW" or footage from lines E/2 NE/4 SE/4

Lease Owner Halliburton Oil Producing Company

Lease Name Curtis Well No. 1

Office Address Cameron Building, 2915 Classen Boulevard, Oklahoma City, Okla.

Character of Well (completed as Oil, Gas or Dry Hole) Dry Hole

Date well completed September 30 19 63

Application for plugging filed September 30 19 63


Application for plugging approved September 30 19 63

Plugging commenced September 30 19 63

Plugging completed September 30 19 63

Reason for abandonment of well or producing formation Dry and Abandoned

If a producing well is abandoned, date of last production 19
Was permission obtained from the Conservation Division or its agents before plugging was commenced? Yes

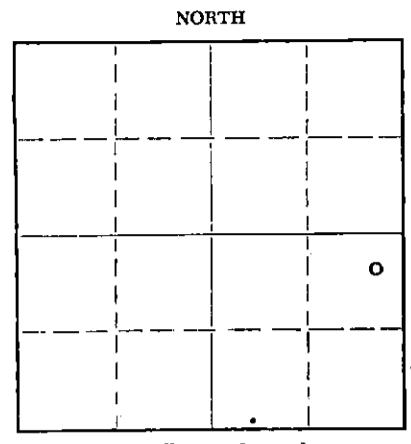

Locate well correctly on above Section Plat

Name of Conservation Agent who supervised plugging of this well Archie V. Klwing, Pratt, Kansas

Producing formation _____ Depth to top _____ Bottom _____ Total Depth of Well _____ Feet
Show depth and thickness of all water, oil and gas formations.

OIL, GAS OR WATER RECORDS

CASING RECORD

FORMATION	CONTENT	FROM	TO	SIZE	PUT IN	PULLED OUT
		0	244'	8 5/8"	244'	none

Describe in detail the manner in which the well was plugged, indicating where the mud fluid was placed and the method or methods used in introducing it into the hole. If cement or other plugs were used, state the character of same and depth placed, from _____ feet to _____ feet for each plug set.

Set plug @ 240' /25 sacks cement
plug @ 40' /12 sacks cement

RECEIVED
STATE CORPORATION COMMISSION

OCT 16 1963

CONSERVATION DIVISION
Wichita, Kansas

(If additional description is necessary, use BACK of this sheet)

Name of Plugging Contractor Hellar Drilling Company, Inc.
Address 1014 Union Center, Wichita, Kansas

STATE OF Kansas COUNTY OF Sedgwick, ss.
D. L. Hellar, Pres. of Hellar Drilling Co. Inc.

(employee of owner) or (owner or operator) of the above-described well, being first duly sworn on oath, says: That I have knowledge of the facts, statements, and matters herein contained and the log of the above-described well as filed and that the same are true and correct. So help me God.

(Signature) D.L. Hellar D.L. Hellar, President
1014 Union Center, Wichita, Kansas
(Address)

SUBSCRIBED AND SWORN TO before me this 9th day of October, 19 63

My commission expires March 25, 1964

Catherine Darcey
Catherine Darcey - Notary Public.




STATE OF KANSAS
STATE CORPORATION COMMISSION

WELL PLUGGING RECORD

Give All Information Completely
Make Required Affidavit
Mail or Deliver Report to:
Conservation Division
State Corporation Commission
212 North Market, Insurance Bldg.
Wichita, Kansas

Stafford County. Sec. 28 Twp. 22S Rge. ---(E)12 (W)

Location as "NE/CNW/SW" or footage from lines E/2 NE SE
Lease Owner Halliburton Oil Producing Company
Lease Name Curtiss Well No. 1
Office Address 520 Cameron Bldg. 2915 Classen Blvd., Okla. City 6, Okla.
Character of Well (completed as Oil, Gas or Dry Hole) Dry Hole
Date well completed September 30, 1963 1963
Application for plugging filed Verbal September 30 1963
Application for plugging approved Verbal September 30 1963
Plugging commenced September 30 1963
Plugging completed September 30 1963
Reason for abandonment of well or producing formation Dry

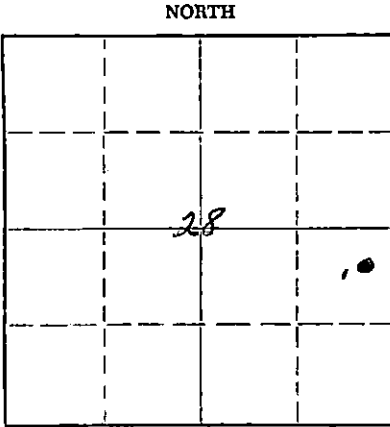

Locate well correctly on above
Section Plat

If a producing well is abandoned, date of last production --- 19---
Was permission obtained from the Conservation Division or its agents before plugging was commenced? Yes

Name of Conservation Agent who supervised plugging of this well A. Elving
Producing formation None Depth to top --- Bottom --- Total Depth of Well 3710 Feet
Show depth and thickness of all water, oil and gas formations.

OIL, GAS OR WATER RECORDS

CASING RECORD

FORMATION	CONTENT	FROM	TO	SIZE	PUT IN	PULLED OUT
Arbuckle	Water	3704	3710	8 5/8	244'	None

Describe in detail the manner in which the well was plugged, indicating where the mud fluid was placed and the method or methods used in introducing it into the hole. If cement or other plugs were used, state the character of same and depth placed, from --- feet to --- feet for each plug set.

Filled hole with heavy mud. Pushed plug to 240'. Put 25 sacks cement plug 160' to 240'. Filled hole with heavy mud 160' to 40' put plug at 40'. Filled casing with 10 sacks cement. Plugged rathole with 2 sacks cement.

RECEIVED
STATE CORPORATION COMMISSION

OCT 4 1963

CONSERVATION DIVISION
Wichita, Kansas

(If additional description is necessary, use BACK of this sheet)

Name of Plugging Contractor Hellar Drilling Company
Address Union Center Building Wichita, Kansas

STATE OF Oklahoma, COUNTY OF Oklahoma, ss.
D.D. Swearingen (employee of owner) or (owner or operator) of the above-described well, being first duly sworn on oath, says: That I have knowledge of the facts, statements, and matters herein contained and the log of the above-described well as filed and that the same are true and correct. So help me God.

(Signature) D. D. Swearingen
520 Cameron Building Okla. City 6, Oklahoma
(Address)

SUBSCRIBED AND SWORN TO before me this 3rd day of October 1963

My commission expires April 15, 1966

Margorie L. Lusk
Notary Public



DRILLER'S LOG

COMPANY: Halliburton Oil Producing Company
 CONTRACTOR: Hellar Drilling Company, Inc.
 LEASE: #1 Curtis
 LOCATION: E/2 NE/4 SE/4 Sec. 28-22S-12W, Stafford County, Ks.
 COMMENCED: September 21, 1963
 COMPLETED: September 30, 1963
 CASING: Set 8 5/8" surface casing @ 244'/200 sacks cement

0-244	Plug & cement
244-660	Shale-Red Beds-sand
660-668	Anhydrite
668-1567	Shale-Red Beds-Lime Streaks
1567-2040	Lime & Shale
2040-2223	Shale
2223-2742	Shale & Lime
2742-2952	Lime & Shale
2952-3185	Shale & Lime
3185-3329	Lime & Shale
3329-3550	Lime
3550-3630	Lime & chert
3630-3700	Lime
3700-3710	Lime Arbuckle
3710	Rotary Total Depth
	Dry & Abandoned

RECEIVED
STATE CORPORATION COMMISSION

OCT 16 1963

CONSERVATION DIVISION
Wichita, Kansas

STATE OF KANSAS)
) SS
 COUNTY OF SEDGWICK)

I, D. L. Hellar do hereby certify that the above and foregoing is a true and correct copy of the log of the #1 Curtis, located in E/2 NE/4 SE/4 Section 28-22S-12W, Stafford County, Kansas, as reflected by the files of the Hellar Drilling Company, Inc.

HELLAR DRILLING COMPANY, INC.

By *D. L. Hellar*
 President - D. L. Hellar

Subscribed and sworn to before me, a Notary Public, in and for Sedgwick County, Kansas, this 9th day of October, 1963.

My Commission Expires:
 March 25, 1964.

Catherine Darcey
 Notary Public - Catherine Darcey