

STATE OF KANSAS
STATE CORPORATION COMMISSION

WELL PLUGGING RECORD


FORMATION PLUGGING RECORD

Give All Information Completely
No. 16 Required Affidavit
Mail or Deliver Report to:
Conservation Division
State Corporation Commission
800 B. King Building
Wichita, Kansas

OR

Strike out upper line
when reporting plug-
ging off formations.

NORTH

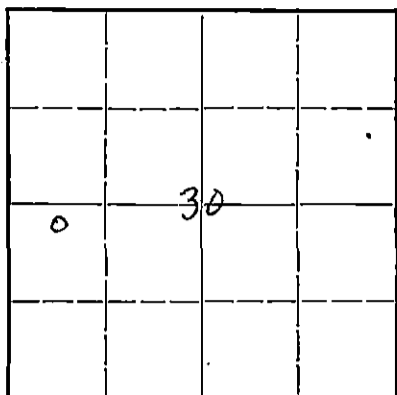

Locate well correctly on above
Section Plat

Stafford County. Sec. 30 Twp. 22 Rge. 12 (W)
Location as "NE 1/4 NW 1/4 SW 1/4" or footage from lines C. N. L. NW SW
Lease Owner Three Way Drlg. Co. & Texon Oil & Land Co.
Lease Name Emma Witt Well No. 1
Office Address
Character of Well (completed as Oil, Gas or Dry Hole) Dry Hole
Date well completed April 20, 1947
Application for plugging filed 19
Application for plugging approved 19
Plugging commenced April 20, 1947
Plugging completed April 20, 1947
Reason for abandonment of well or producing formation Dry Hole
If a producing well is abandoned, date of last production 19
Was permission obtained from the Conservation Division or its agents before plugging was com-
menced? Yes

Name of Conservation Agent who supervised plugging of this well Mr. H. W. Kerr
Producing formation Depth to top Bottom Total Depth of Well 3785 Feet
Show depth and thickness of all water, oil and gas formations.

OIL, GAS OR WATER RECORDS

CASING RECORD

Formation	Content	From	To	Size	Put In	Pulled Out
Surface		0	230'	10"	230'	0

Describe in detail the manner in which the well was plugged, indicating where the mud fluid was placed and the method or methods used in introducing it into the hole. If cement or other plugs were used, state the character of same and depth placed, from feet to feet for each plug set.

Filled hole with mud to 240', drove plug to 240', set 15 sacks cement at 240', filled hole to 25' of top, ran 10 sacks cement on top of pipe.

4-26-47

APR 30 1947

(If additional description is necessary, use BACK of this sheet)

Correspondence regarding this well should be addressed to Three Way Drilling Company,
Address 607 Union National Bank Building, Wichita 2, Kansas

STATE OF Kansas, COUNTY OF Sedgwick, ss.

(employee of owner) or (owner or operator) of the above-described well,
being first duly sworn on oath, says: That I have knowledge of the facts, statements, and matters herein contained and the log of the above-described well as filed and that the same are true and correct. So help me God.

THREE WAY DRILLING COMPANY,
(Signature) By: [Signature]
607 Union National Bank Bldg.
Wichita 2, Kansas

SUBSCRIBED AND SWORN to before me this 25 day of April, 1947
[Signature] Notary Public

My commission expires 9-10-50

PLUGGING
FILE SEC 30 T 22 R 124
BOOK PAGE 107 LINE 22

Company: Three Way Drilling Co.
& Texon Oil & Land Co.

C N L NW SW
Sec. 30 Twp. 22S Range 12 W
Stafford County, Kansas

Farm: Emma Witt No. 1

Total Depth: 3785'

Comm: 4-1-47 Comp: 4-20-47

Contractor: Three Way Drilling Co.

Production: Dry

Casing:

10" 230' Cem.

150 Sand
200 Shale
220 Shale & Shells
240 Red Rock
320 Red Beds
340 Broken Shells
550 Red Beds
695 Red Rock
735 Anhydrite
780 Red Rock & Shale
950 Shale & Shells
975 Lime Streaks
1089 Lime Breaks
1200 Shale & Shells
1488 Salt
1565 Shale & Red Beds
1645 Lime & Shale
1782 Lime
1865 Brown Lime
1936 Lime Broken
1940 Lime
2005 Lime Broken
2074 Lime
2250 Lime Broken
2280 Lime
2310 Broken Lime
2345 Shale
2375 Shale & Shells
2404 Shale & Lime
2905 Shale
3046 Lime
3071 Green Shale
3120 Lime
3150 Lime & Shale
3275 Lime
3385 Shale
3575 Lime
3650 Shale & Lime
3655 Chert & Lime
3680 Chert
3691 Chat
3705 Shale
3716 Shale & Lime
3740 Sand & Shale
3770 Shale
3785 Lime
Total Depth

TOPS:

Lansing 3362
Viola 3642
Simpson 3710
Arbuckle 3785

STATE OF KANSAS)
SEDGWICK COUNTY) SS:

H. W. LEWIS, Three Way Drilling Company, of lawful age,
being first duly sworn under oath, states that the THREE WAY
DRILLING COMPANY was the Contractor engaged for the drilling
of the Emma Witt No. 1 located in the Center North Line North-
west Quarter of the Southwest Quarter of Section 30, Township
22 South, Range 12 West, Stafford County, Kansas, and the fore-
going log is a true and correct copy of the log of the completed
well.

THREE WAY DRILLING COMPANY

By *H. W. Lewis*
H.-W. Lewis.

Subscribed and sworn to before me, a Notary Public, in and for
the county and state above mentioned, this 25th day of April,
1947.

Emma A. Fugate
Notary Public.

My Commission Expires: 9-10-50