

STATE OF KANSAS
STATE CORPORATION COMMISSION

WELL PLUGGING RECORD


OR

FORMATION PLUGGING RECORD

Strike out upper line when reporting plugging off formations.

Give All Information Completely
Make Required Affidavit
Mud or Drilling Report to:
Conservation Division
State Corporation Commission
800 Bittling Building
Wichita, Kansas

NORTH

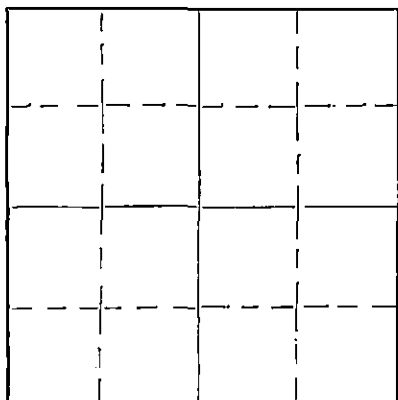

Locate well correctly on above
Section Plat

.....Pawnee.....County. Sec. 21... Twp. 22 Rge. (E) 16 (W)
Location as "NE 1/4 NW 1/4 SW 1/4" or footage from lines..... C. E. L. NE SW
Lease Owner..... Lauck-Moncrief, Derby Oil Co; I.T.I.O. Co.
Lease Name..... Gilkison..... Well No. 1
Office Address..... 520 Fourth National Bank Bldg. Wichita
Character of Well (completed as Oil, Gas or Dry Hole)..... dry hole
Date, well completed..... May 16..... 1940
Application for plugging filed..... May 16..... 1940
Application for plugging approved..... May 16..... 1940
Plugging Commenced..... May 16..... 1940
Plugging Completed..... May 16..... 1940
Reason for abandonment of well or producing formation..... dry

If a producing well is abandoned, date of last production..... 193
Was permission obtained from the Conservation Division or its agents before plugging was commenced?..... yes

Name of Conservation Agent who supervised plugging of this well..... Alexander
Producing formation..... Depth to top..... Bottom..... Total Depth of Well..... Feet
Show depth and thickness of all water, oil and gas formations.

OIL, GAS OR WATER RECORDS


CASING RECORD

Formation	Content	From	To	Size	Put In	Pulled Out
<u>Arbuckle lime</u>	<u>water</u>	<u>4105</u>	<u>4125</u>	<u>10"</u>	<u>696</u>	<u>none</u>

Describe in detail the manner in which the well was plugged, indicating where the mud fluid was placed and the method or methods used in introducing it into the hole. If cement or other plugs were used, state the character of same and depth placed, from..... feet to..... feet for each plug set.

Filled hole with heavy mud 4125- 696
Bridged hole:
Plugged 696-681 15 sacks cement
plugged 681- 25' heavy mud
plugged 25- to bottom of cellar with cement
welded cap on surface casing

PLUGGING
FILE SEC 21-22R-16W
BOOK 103 LINE 30

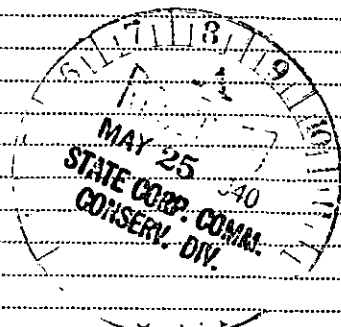

(If additional description is necessary, use BACK of this sheet)

Correspondence regarding this well should be addressed to.....
Address..... Lauck & Moncrief Wichita, Kans.

STATE OF Kansas, COUNTY OF Sedgwick, ss.
E. C. Moncrief (owner or operator) of the above-described well,
being first duly sworn on oath, says: That I have knowledge of the facts, statements, and matters herein contained and the log of the above-described well as filed and that the same are true and correct. So help me God.

(Signature)..... E. C. Moncrief
..... 520 Fourth Nat'l Bldg. Wichita
(Address)

SUBSCRIBED AND SWORN TO before me this 23rd day of May, 1940

My commission expires Sept. 14, 1943

Elizabeth Day
Notary Public.

No. 1 Gilkison

Sec. 21-22-16W CEL NE SW
Commenced April 22, 1940

Pawnee County, Kansas
Completed May 16, 1940

Casing 10" 696 cemented 330 sacks

The Derby Oil Company
I.T.I.O. Co.
Lauck & Moncrief

Shale	70
sand	100
shale & shells blue	290
shale & shells	367
sand	375
shale	427
sandy red rock	452
red rock	475
sand	478
red rock	490
sand-water	565
sandy red rock	660
sand	680
red rock with shells	693
red rock	703
red rock & shale	980
red rock	1024
Anhydrite	1055
shale & red rock	1245
red rock	1325
sand & sandy shale	1445
shale & shells	1635
shale	1677
Anhydrite & lime	1710
shale & red rock	1740
shale & red rock shelly	1830
broken lime	1940
Anhydrite & lime	1995
Anhydrite & shale	2030
shale	2045
Anhydrite	2100
lime	2105
shale	2120
lime	2130
shale	2135
Lime & Anhydrite	2170
lime & shale	2230
sandy lime	2258
shale & lime	2275
lime	2335
lime & shale	2495
lime	2755
shale & shells	2820
shale & lime	2900
broken lime	2980
shale & shells	3120
broken lime	3135
shale & shells	3140

broken lime	3144
shale & shells	3175
broken lime	3215
shale	3233
lime	3250
broken lime	3315
lime	3530
shale	3557
lime	3575
broken lime	3640
shale	3660
broken lime	3665
Top Lansing 3341	
lime & shale	3682
lime	3726
lime & shale	3731
lime	3749
lime porous	3759
lime	3943
Conglomerate	4006
shale & lime	4024
Conglomerate	4105
lime	4125

T.D. 4125

dry- abandoned

PLUGGING
FILE SEC 21-22-16W
BOOK PAGE 103 LINE 30

