


STATE OF KANSAS
STATE CORPORATION COMMISSION

WELL PLUGGING RECORD

Give Information Completely
Make Affidavit
Mail or Deliver Report to:
Conservation Division
State Corporation Commission
800 Bittig Building
Wichita, Kansas

NORTH

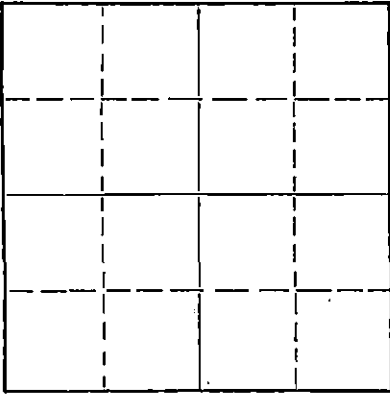

Locate well correctly on above
Section Plat

Kingman County. Sec. 1 Twp. 30 Rge. (E) 10(W)
Location as "NE/CNWxSWx" or footage from lines SW SW NE
Lease Owner Jones, Shelburne & Farmer, Inc.
Lease Name Carter Well No. 1
Office Address Russell, Kansas
Character of Well (completed as Oil, Gas or Dry Hole) Dry
Date well completed 4-22 1955
Application for plugging filed 4-22 1955
Application for plugging approved 4-22 1955
Plugging commenced 4-22 1955
Plugging completed 4-22 1955
Reason for abandonment of well or producing formation Dry

If a producing well is abandoned, date of last production _____ 19____
Was permission obtained from the Conservation Division or its agents before plugging was commenced? Yes

Name of Conservation Agent who supervised plugging of this well Ruel Durkee
Producing formation _____ Depth to top _____ Bottom _____ Total Depth of Well 3693 Feet
Show depth and thickness of all water, oil and gas formations.

OIL, GAS OR WATER RECORDS

CASING RECORD

FORMATION	CONTENT	FROM	TO	SIZE	PUT IN	PULLED OUT
				8-5/8	342'	None

Describe in detail the manner in which the well was plugged, indicating where the mud fluid was placed and the method or methods used in introducing it into the hole. If cement or other plugs were used, state the character of same and depth placed, from _____ feet to _____ feet for each plug set.

- Filled hole to 342' with heavy mud
- Pushed Halliburton plug to 342' with drill pipe and dumped 1/2 sack hulls on top of plug
- Spotted 15 sacks cement through drill pipe on top of plug
- Filled hole to 40' with heavy mud
- Pushed 2nd Halliburton plug to 40' and dumped 1/2 sack hull on top of plug
- Filled hole to top with 10 sacks cement.

RECEIVED
MAY 1 1955
CONSERVATION DIVISION
Wichita, Kansas
5-3-55

Name of Plugging Contractor Jones, Shelburne & Farmer, Inc.
Address Russell, Kansas

STATE OF KANSAS, COUNTY OF RUSSELL, ss.
John O. Farmer (employee of owner) or (owner or operator) of the above-described well, being first duly sworn on oath, says: That I have knowledge of the facts, statements, and matters herein contained and the log of the above-described well as filed and that the same are true and correct. So help me God.

(Signature) John O. Farmer
Russell, Kansas
(Address)

SUBSCRIBED AND SWORN TO before me this 29th day of April, 1955

My commission expires October 11, 1958
Lucille Kennedy Notary Public.

PLUGGING
FILE SEC 1 T 30 R 10W
BOOK PAGE 114 LINE 23


OPERATOR Jones, Shelburne & Farmer, Inc.

FORMATION RECORD

ADDRESS Russell, Kansas

Give detailed description and thickness of all formations drilled through, contents of sand, whether dry, water, oil or gas.

640 Acres
N

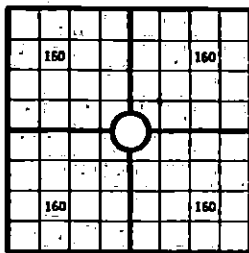

Locate well correctly

COUNTY Kingman SEC. 1 TWP. 30 RGE. 10
 COMPANY OPERATING Jones, Shelburne & Farmer, Inc.
 OFFICE ADDRESS Russell, Kansas
 FARM NAME Carter WELL NO. 1
 DRILLING STARTED 4-2, 1955 DRILLING FINISHED 4-22, 1955
 DATE OF FIRST PRODUCTION _____ COMPLETED _____
 WELL LOCATED SW 1/4, SW 1/4, NE 1/4, North of South
 Line and _____ ft. East of West Line of Quarter Section
 Elevation (Relative to sea level) DERRICK FLOOR 168 GROUND 67.6
 CHARACTER OF WELL (Oil, gas or dryhole) Dry

OIL OR GAS SANDS OR ZONES

Name	From	To	Name	From	To
			4		
			5		
			6		

Perforating Record If Any

Shot Record

Formation	From	To	No. of Shots	Formation	From	To	Size of Shot

CASING RECORD

Amount Set				Amount Pulled				Packer Record			
Size	Wt.	Thds.	Make	Ft.	In.	Ft.	In.	Size	Length	Depth Set	Make
8-5/8				320							

Liner Record: Amount _____ Kind _____ Top _____ Bottom _____

CEMENTING AND MUDDING

Size	Amount Set		Sacks Cement	Chemical		Method of Cementing	Amount	Mudding Method	Results (See Note)
	Ft.	In.		Gal.	Make				
8-5/8	320		200						

Note: What method was used to protect sands if outer strings were pulled?

NOTE: Were bottom hole plugs used? If so, state kind, depth set and results obtained

TOOLS USED

Rotary Tools were used from _____ feet to _____ Cable tools were used from _____ feet to _____
 _____ feet and from _____ feet to _____ feet and from _____ feet to _____
 Type _____

INITIAL PRODUCTION TEST

Describe method whether by flow through tubing or casing or by pumping _____
 Amount of Production _____ bbls. Size of choke, if any _____ Length of test _____ Water
 Production _____ bbls. Gravity of oil _____ Type of Pump if pump is used, describe _____

Formation	Top	Bottom	Formation	Top	Bottom
Surface	0	320	Lime	4315	4340
Shale	320	925	Sahle & lime	4340	4519
Shale & shells	925	1125	Viola	4519	4574
Shale	1125	1475	S sand	4574	4605
Lime & shale streaks	1475	1540	S sand & shale	4605	4635
Lime & shale	1540	2085	Shale & Lime	4635	4679
Lime & shale streaks	2085	2190	Arb.	4679	4693
Shale & lime	2190	2300	T.D.		4693
Lime & shale	2300	2445			
Shale & lime	2445	2750			
Sandy lime & shale	2750	2860			
Shale & Lime sandy	2860	2995	TOPS:		
Shale & lime	2995	3125	Elevation	RB	1683
Lime	3125	3225	Heebner		3423
Lime & shale	3225	3340	Douglas sand		3467
Lime & shale (sandy)	3340	3395	Lansing		3650
Lime & shale	3395	3460	Mississippi		4245
Sandy Lime & shale	3460	3630	Viola		4511
Lime & shale	3630	3690	Simpson		4574
Lime	3690	3815	Arbuckle		4679
Lime & shale streaks	3815	3845	T.D.		4693
Lime & shale	3845	3970			
Lime	3970	4035			
Lime & shale	4035	4180			
Lime	4180	4250			
Miss. chert	4250	4280			
Miss-(cherty)	4280	4300			
Lime & shale	4300	4315			

I, the undersigned, being first duly sworn upon oath, state that this well record is true, correct and complete according to the records of this office and to the best of my knowledge and belief.

John Farmer Vice-Pres
 Name and title of representative of company

Subscribed and sworn to before me this 27th day of April, 1955.
 My Commission expires 10-11-58
Lucretia Finney
 Notary Public.

15-095-00080-0000
 FARM NAME Carter
 WELL NO. 1 COUNTY Kingman SEC. 1 TWP. 30 RGE. 10

PLUGGING
 4-2-55
 4-22-55