


STATE OF KANSAS
STATE CORPORATION COMMISSION

WELL PLUGGING RECORD

Give All Information Completely
Make Required Affidavit
Mail & Deliver Report to:
Conservation Division
State Corporation Commission
211 No. Broadway
Wichita, Kansas

Pawnee County. Sec. 35 Twp. 22S Rge. (E) 18 (W)
Location as "NE/CNW/SW" or footage from lines SW/SW/SW
Lease Owner Columbia Supply
Lease Name Lewis Hall Well No. 1
Office Address Great Bend, Kansas
Character of Well (completed as Oil, Gas or Dry Hole) dry
Date well completed _____ 19____
Application for plugging filed 4-5- 1956
Application for plugging approved _____ 19____
Plugging commenced 4-20 1956
Plugging completed 4-27 1956
Reason for abandonment of well or producing formation _____

NORTH

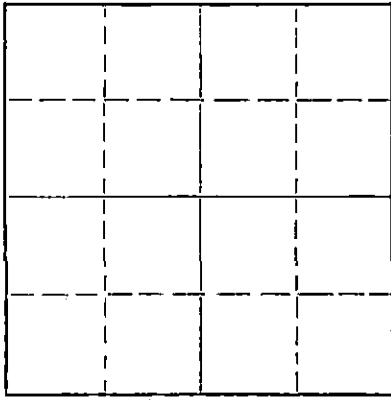

Locate well correctly on above
Section Plat

If a producing well is abandoned, date of last production _____ 19____
Was permission obtained from the Conservation Division or its agents before plugging was commenced? yes

Name of Conservation Agent who supervised plugging of this well Brundege
Producing formation _____ Depth to top _____ Bottom _____ Total Depth of Well 4465 Feet
Show depth and thickness of all water, oil and gas formations.

OIL, GAS OR WATER RECORDS

CASING RECORD

FORMATION	CONTENT	FROM	TO	SIZE	PUT IN	PULLED OUT
				5 1/2"		3179.83

Describe in detail the manner in which the well was plugged, indicating where the mud fluid was placed and the method or methods used in introducing it into the hole. If cement or other plugs were used, state the character of same and depth placed, from _____ feet to _____ feet for each plug set.

Plugging commenced 4-20-56 and completed 4-27-56. Measured in to T. D. 4465'.
Plugged off bottom with sand back to 4290' and dumped in 5 sacks of cement.
Shot casing off at 3179.83' and pulled out pipe. Plugged well as follows:
Filled hole with heavy mud to 300' and set permanent rock bridge. Dumped in 20
sacks of cement mud to 35' and set permanent rocks bridge. Capped well with 10 sa
sacks of cement.

(If additional description is necessary, use BACK of this sheet)

Name of Plugging Contractor J. O. Forbes d/b/a Forbes Casing Pulling Company
Address Box 221, Great Bend, Kansas

STATE OF Kansas, COUNTY OF Barton, ss.
J. O. Forbes (employee of owner) or (owner or operator) of the above-described well, being first duly sworn on oath, says: That I have knowledge of the facts, statements, and matters herein contained and the log of the above-described well as filed and that the same are true and correct. So help me God.

(Signature) J. O. Forbes
(Address) _____

SUBSCRIBED AND SWORN to before me this 7 day of May, 1956

My commission expires April 8, 1957
Arthur J. Shickel Notary Public.

PLUGGING
FILE SEC 35 22 18W
BOOK PAGE 51 44

RECEIVED
STATE CORPORATION COMMISSION
MAY 28 1956
CONSERVATION DIVISION
Wichita, Kansas

5-2-56

Well Log
Well # 1
SE SW SW 35-22-10
Pawnee County, Kansas

0 - 40	Surface clay
40 - 80	Sand and shale
80 - 145	Shale and shells
145 - 210	Sand
210 - 254	Shale and shells
254 - 340	Blue shale
340 - 450	Shale and shells
450 - 560	Red bed
560 - 580	Soft lime
580 - 665	Shale and shells
665 - 735	Dakota
735 - 850	Red bed and shale
850 - 990	Red bed
990 - 1015	Red bed - shale - shells
1015 - 1030	Red bed
1030 - 1215	Red bed, shale
1215 - 1228	Anhydrite
1228 - 1260	Red bed, shale
1260 - 1650	Shale and shells
1650 - 1740	Salt
1740 - 1810	Shale and shells
1810 - 2090	Lime and shale
2090 - 2135	Lime
2135 - 2195	Lime - shale
2195 - 2305	Lime
2305 - 2320	Sand
2320 - 2330	Lime and shale
2330 - 2415	Lime
2415 - 2460	Shale - lime
2460 - 2470	Sand
2470 - 2475	Sand - Fort Riley
2475 - 2545	Lime and shale - Fort Riley
2545 - 2635	Lime
2635 - 2810	Lime and shale - Fort Riley
2810 - 2925	Lime and shale
2925 - 2965	Lime and shale streaks
2965 - 3450	Shale and lime
3450 - 3480	Sand and lime and shale
3480 - 3540	Shale and lime
3540 - 3550	Lime
3550 - 3760	Lime and shale
3760 - 3832	Brown lime
3832 - 4220	Kansas City lime
4220 - 4250	Shale and lime
4250 - 4255	Sand
4255 - 4340	Lime and shale
4340 - 4396	Mississippi and chert
4396 - 4410	Sand
4410 - 4436	Lime and shale
4436 - 4465	Viola lime and chert
4465	T. D.

STATE OF KANSAS
COUNTY OF BARTON

A. L. Jackson, owner of A. L. Jackson Drilling Company, being first duly sworn on oath, says that I have knowledge of the facts, statements, and matters herein contained and the log of the above described well as filed and that the same are true and correct.

PLUGGING

SEC 35 22 10
5.1.1955 41

A. L. Jackson
A. L. Jackson

Subscribed and sworn to before me this 29th day of June, 1955.

Virgil E. Dolan
Virgil E. Dolan, J.P.
Notary Public Barton County

My commission expires April 27, 1957