


STATE OF KANSAS
STATE CORPORATION COMMISSION

WELL PLUGGING RECORD

Give All Information Completely
Make Required Affidavit
Mail or Deliver Report to
Conservation Division
State Corporation Comm.
245 North Water
Wichita, KS 67202

Pawnee County, Sec. 26 Twp. 22 Rge. 18 E/W
Location as "NE/CNW $\frac{1}{4}$ SW $\frac{1}{4}$ " or footage from lines
SE NE NE

Lease Owner American Energies Corporation
Lease Name Meckfessel Well No. 1
Office Address 680 Fourth Financial Center, Wichita, KS
Character of Well (Completed as Oil, Gas or Dry Hole)
Dry Hole

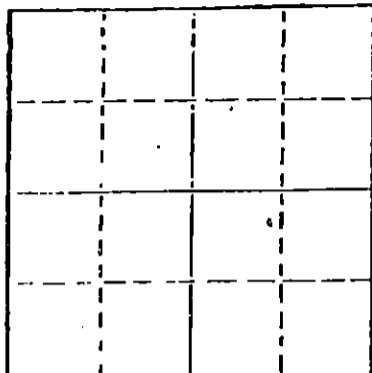

Locate well correctly on above
Section Plot

Date Well completed Nov. 25 1978
Application for plugging filed (verbally) Nov. 25 1978
Application for plugging approved (verbally) Nov. 25 1978
Plugging commenced Nov. 25 1978
Plugging completed Nov. 25 1978
Reason for abandonment of well or producing formation
No commercial quantity of oil or gas encountered.
If a producing well is abandoned, date of last production
19

Was permission obtained from the Conservation Division or
its agents before plugging was commenced? yes

Name of Conservation Agent who supervised plugging of this well Leo Massey
Producing formation _____ Depth to top _____ Bottom _____ Total Depth of Well 4400'
Show depth and thickness of all water, oil and gas formations.

OIL, GAS OR WATER RECORDS

CASING RECORD

FORMATION	CONTENT	FROM	TO	SIZE	PUT IN	PULLED OUT

Describe in detail the manner in which the well was plugged, indicating where the mud fluid
was placed and the method or methods used in introducing it into the hold. If cement or other
plugs were used, state the character of same and depth placed, from _____ feet to
_____ feet for each plug set.

RECEIVED

STATE CORPORATION COMMISSION

T.D. 4400'

Set 1st plug at 600' with 50 sacks

2nd plug at 300' with 40 sacks

3rd plug $\frac{1}{2}$ sack hulls and bridge at 40' with 12 sacks
rathole with 3 sacks

Plug was down at 5:30 p.m., 11-25-78.

State Plugger - Leo Massey.

CONSERVATION DIVISION
Wichita, Kansas

12-7-78

(If additional description is necessary, use BACK of this sheet)

Name of Plugging Contractor Abercrombie Drilling, Inc.

STATE OF Kansas COUNTY OF Sedgwick, ss.
Jack L. Partridge, Asst. Sec.-Treas. (employee of owner) or (owner or operator)
of the above-described well, being first duly sworn on oath, says: That I have knowledge of
the facts, statements, and matters herein contained and the log of the above-described well
as filed and that the same are true and correct. So help me God.



(Signature)

Jack L. Partridge
801 Union Center, Wichita Kansas 67202

(Address)

SUBSCRIBED AND SWORN TO before me this 5th day of December, 1978

Sherrie L. Brooks
Sherrie L. Brooks Notary Public.

My commission expires 8-21-82

OPERATOR: American Energies Corporation
 CONTRACTOR: Abercrombie Drilling, Inc.
 WELL NAME: Meckfessel #1
 LOCATION: SE NE NE, Section 26-22-18,
 Pawnee County, Kansas
 SPUD DATE: November 17, 1978
 COMPLETION DATE: November 25, 1978

0	161	Surface soil & sand
161	610	Red Bed & sand
610	766	Shale & sand
766	1483	Shale & red bed
1483	1849	Shale
1849	2307	Shale & Lime
2307	3731	Lime & Shale
3731	3870	Shale & Lime
3870	4290	Lime & Shale
4290	4295	Shale & Lime
4295	4400	Lime & Shale
	4400	Rotary Total Depth

Spud hole at 12:30 p.m., November 16, 1978. Drilled 766' of 12 1/4" hole. Ran 8 joints of 8 5/8" used 28# casing. Set at 313' with 235 sacks of common cement, 3% Ca.Cl., 2% gel. Cement did circulate. Plug was down at 5:45 a.m., November 17, 1978.

T.D. 4400'. Set 1st plug at 600' with 50 sacks, 2nd plug at 300' with 40 sacks, 1/2 sack hulls and bridge at 40' with 12 sacks, rathole with 3 sacks. Plug was down at 5:30 p.m., November 25, 1978.


STATE OF KANSAS)
) ss
 COUNTY OF SEDGWICK)

Jack L. Partridge, Assistant Secretary-Treasurer of Abercrombie Drilling, Inc., does hereby state that the above and foregoing is a true and correct copy of the log of the Meckfessel #1, SE NE NE, Section 26-22-18, Pawnee County, Kansas.

ABERCROMBIE DRILLING, INC.

BY Jack L. Partridge
 Jack L. Partridge

Subscribed and sworn to before me, a Notary Public, in and for the county and state aforesaid, as of this 5th day of December, 1978.

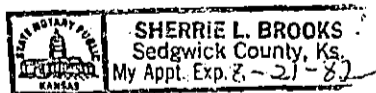

Sherrie Brooks
 Sherrie Brooks, Notary Public

My commission expires 8-21-82.

RECEIVED
 STATE CORPORATION COMMISSION

DEC - 7 1978

CONSERVATION DIVISION
 Wichita, Kansas