


WELL PLUGGING RECORD

Give All Information Completely  
Make Required Affidavit  
Mail or Deliver Report to:  
Conservation Division  
State Corporation Commission  
800 Bittig Building  
Wichita, Kansas

NORTH

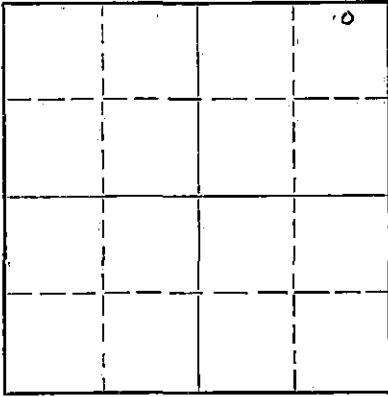

Locate well correctly on above  
Section Plat

Pawnee County, Sec. 1 Twp. 22 Rge. 18 (E) W (W)

Location as "NE/CNW/SW" or footage from lines NE NE NE  
Lease Owner Harms-Burt Drilling Co.  
Lease Name Scherzer Well No. 1  
Office Address Box 184, Great Bend, Kansas  
Character of Well (completed as Oil, Gas or Dry Hole) Dry Hole  
Date well completed February 9 19 56  
Application for plugging filed February 9 19 56  
Application for plugging approved February 9 (verbally) 19 56  
Plugging commenced February 9 19 56  
Plugging completed February 9 19 56  
Reason for abandonment of well or producing formation Dry Hole

If a producing well is abandoned, date of last production \_\_\_\_\_ 19\_\_\_\_  
Was permission obtained from the Conservation Division or its agents before plugging was commenced? yes

Name of Conservation Agent who supervised plugging of this well R.M. Brundege, Box 283, Hoisington, Kansas  
Producing formation \_\_\_\_\_ Depth to top \_\_\_\_\_ Bottom \_\_\_\_\_ Total Depth of Well 4203 Feet  
Show depth and thickness of all water, oil and gas formations.

OIL, GAS OR WATER RECORDS

CASING RECORD

FORMATION	CONTENT	FROM	TO	SIZE	PUT IN	PULLED OUT
Surface		0	203	8 5/8"	203	none

Describe in detail the manner in which the well was plugged, indicating where the mud fluid was placed and the method or methods used in introducing it into the hole. If cement or other plugs were used, state the character of same and depth placed, from \_\_\_\_\_ feet to \_\_\_\_\_ feet for each plug set.

Plugged hole with mud and then pumped 200 sacks of common cement into surface pipe.

(If additional description is necessary, use BACK of this sheet)

Name of Plugging Contractor Harms-Burt Drilling Co.  
Address Box 184, Great Bend, Kansas

STATE OF Kansas, COUNTY OF Barton, ss.  
Allan Harms (employee of owner) or (owner or operator) of the above-described well, being first duly sworn on oath, says: That I have knowledge of the facts, statements, and matters herein contained and the log of the above-described well as filed and that the same are true and correct. So help me God.


(Signature) Allan Harms  
Box 184, Great Bend, Kansas  
(Address)

SUBSCRIBED AND SWORN TO before me this 26 day of February, 19 56

My commission expires 1-20-58

Mary E Van Pelt  
Notary Public.

FEB 21 1956

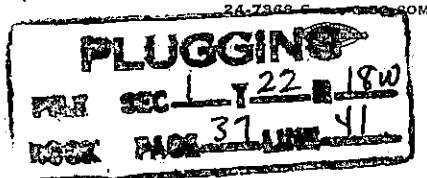

CONSERVATION DIVISION  
Wichita, Kansas

2-21-56

## Driller's Log

Company: Harms-Burt Drilling Co.

Farm: Scherzer No. 1

NE NE NE Section 1-22S-18W Pawnee County, Kansas

Commenced: January 20, 1956

Completed: February 9, 1956

0 - 50	Soil and Clay	3259 - 3425	Lime
50 - 204	Sand and Shale	3425 - 3628	Lime & shale
204 - 390	Shale	3628 - 3782	Lime
390 - 624	Red bed, shale & sand	3782 - 3830	Lime & shale
625 - 665	Sand	3830 - 3900	Lime
665 - 1116	Red bed & shale	3900 - 4030	Lime & shale
1116 - 1141	Anhydrite	4030 - 4054	Shale & lime
1141 - 1225	Shale & shells	4054 - 4060	Chert & sand
1225 - 1520	Shale & red bed	4060 - 4087	Conglomerate
1520 - 1900	Shale & shells	4087 - 4114	Lime & chert
1900 - 2090	Lime	4114 - 4120	Chert & lime
2090 - 2190	Lime & shale	4120 - 4156	Lime & shale
2190 - 2220	Lime & chert	4156 - 4173	Shale & sand
2220 - 2785	Lime	4173 - 4203	Lime (arbuckle)
2785 - 3259	Lime & shale	4203	Total Depth

Set 203 ft. of 8 5/8" surface pipe, cemented with 225 sacks of common cement and four sacks of calcium chloride.

Tops: Anhydrite 1116  
Arbuckle 4173

Drill Stem Tests: No. 1 4020-4060 Open 1 hr. Shut in 20 min.  
Recovered 35' drilling mud. BHP 40#

No. 2 4079-4114 Open 31 min. Shut in 20 min.  
Recovered 60' of watery mud.

Ran Electric log.

Dry, plugged and abandoned.

Affidavit:

State of Kansas, County of Barton, SS:

I, Allan Harms, of Harms-Burt Drilling Company, being first duly sworn on oath state: I have knowledge of the facts, statements, and matters herein contained and the same are true and correct.

Subscribed and sworn to before me this 20 day of February, 1956.

Comm. Exp. 1-20-58

RECEIVED  
STATE CORPORATION COMMISSION  
FEB 21 1956  
CONSERVATION DIVISION  
Topeka, Kansas

PLUGGING  
FILE SEC 1 22 18W  
BOOK PAGE 37 LINE 41